

DEC 07 1994

COPY

1994 REMONUMENTATION PROGRAM
LAND CORNER RECORDATION CERTIFICATE

COMMISSIONER

Filing Requirement of Act 74, Mich. P.A. 1970

For corners in KOYLTON TOWNSHIP

RECEIVED FOR RECORD
LIBER NO. _____ PAGE NO. _____
FILING NO. #37
KOYLTON TWP
94 NOV -9 PM 2:20
VIRGINIA H. MCLAREN
TUSCOLA COUNTY
REGISTER OF DEEDS

Register of Deeds Stamp & File Number

<u>TUSCOLA</u> (County)	Located In:	Corner Code #:
1. Public Land Survey	T11N R11E	M-8
	T _____ R _____	_____
	T _____ R _____	_____
	T _____ R _____	_____
2. Property Controlling in Section	S _____ T _____ R _____	_____
	S _____ T _____ R _____	_____
3. Miscellaneous Property in Sec.	S _____ T _____ R _____	_____
	S _____ T _____ R _____	_____
4. Lot No. _____, Recorded Plat _____		
5. Private Claims _____		

A	B	C	D	E	F	G	H	I	J	K	L
2	6	5	4	3	2						
3											
4	7	8	9	10	11	12					
5											
6	16	17	16	15	14	13					
7											
8	19	20	21	22	23	24					
9											
10	30	29	28	27	26	25					
11											
12	31	32	33	34	35	36					
13											

I, Lionel Roy Emery, in a field survey on June 20, 1994, do hereby certify that under requirements of P.A. 74, Michigan P.A. of 1970, the corner points mentioned in lines 1 and 2 above were in conformance with regulations and rules therefore as required in the current manual of survey instructions of the United States Department of the Interior, Bureau of Land Management or by a decree of a Court of Law and/or that the corner points mentioned in lines 3, 4 and 5 above were in conformance with the rules of the Michigan Board of Land Surveyors or by a Decree of a Court of Law, established, re-established, monumented, re-monumented, recovered, found as expressed below:

NOTE: Not more than 4 corners, all in the same town and range, may be recorded on this certificate.

A. Description of original monument and accessories and/or subsequent restoration:


- 1834 (Gov't. Land Office Notes) Harvey Parke, D.S. -Set quarter section post- Cedar 10 N43W 20 B. Ash 10 S76W 9
- 1986 (Survey -Liber 560, pages 1038 & 1040) Charles S. Getz P.S. 25843 -drawing shows 1/2" Iron Old Cor Post, no indication whether found or set and gives no accessories

B. Description of corner evidence found and/or method applied in restoring or reestablishing corner:

Found 1/2" diameter reinforcing rod at intersection of East-West fence and fence North
Accepted 1/2" diameter reinforcing rod as marking original corner.

C. Description of monument for corner and accessories established to perpetuate locating the position of the corner:

Removed 1/2" reinforcing rod and replaced with Standard Tuscola County Concrete Monument w/2" Brass Cap stamped M8 T11N/R11E
N02°E, 102.24'-T.C. Remon. tag in West face of 18" Elm
S85°E, 32.07'-T.C. Remon. tag in South face of 14" Elm
N85°W, 75.91'-T.C. Remon. tag in North face of 14" Apple Tree
N05°W, 49.75'-T.C. Remon. tag in East face of 10" Elm

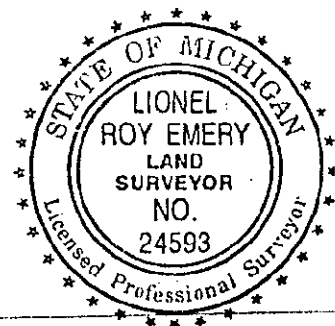

Signed by Lionel Roy Emery Date Sep. 19, 1994
Surveyor's Michigan License No. 24593

APPROVED
9-19-94

COPY

