

DEC 07 1994

COPY

COMMISSION

1994 REMONUMENTATION PROGRAM
LAND CORNER RECORDATION CERTIFICATE
Filing Requirement of Act 74, Mich. P.A. 1970

For corners in KOYLTON TOWNSHIP

RECEIVED FOR RECORD
LIBER NO. _____ PAGE NO. _____
FILING NO. # 38
KOYLTON TWP
94 NOV -9 PM 2:20
VIRGINIA M. McLAREN
TUSCOLA COUNTY
REGISTER OF DEEDS

TUSCOLA (County)	Located In:	Corner Code #:
1. Public Land Survey	T 11N. R 11E	M-9
	T _____ R _____	_____
	T _____ R _____	_____
	T _____ R _____	_____
2. Property Controlling in Section	S _____ T _____ R _____	_____
	S _____ T _____ R _____	_____
3. Miscellaneous Property in Sec.	S _____ T _____ R _____	_____
	S _____ T _____ R _____	_____

Register of Deeds Stamp & File Number

- 4. Lot No. _____, Recorded Plat _____
- 5. Private Claims _____

	A	B	C	D	E	F	G	H	I	J	K	L
2	6		5		4		3		2		1	
3												
4	7		8		9		10		11		12	
5												
6	18		17		16		15		14		13	
7												
8	19		20		21		22		23		24	
9												
10	30		29		28		27		26		25	
11												
12	31		32		33		34		35		36	
13												

I, Lionel Roy Emery, in a field survey on June 20, 19 94, do hereby certify that under requirements of P.A. 74, Michigan P.A. of 1970, the corner points mentioned in lines 1 and 2 above were in conformance with regulations and rules therefore as required in the current manual of survey instructions of the United States Department of the Interior, Bureau of Land Management or by a decree of a Court of Law and/or that the corner points mentioned in lines 3, 4 and 5 above were in conformance with the rules of the Michigan Board of Land Surveyors or by a Decree of a Court of Law; established, re-established, monumented, re-monumented, recovered, found as expressed below:

NOTE: Not more than 4 corners, all in the same town and range, may be recorded on this certificate.

A. Description of original monument and accessories and/or subsequent restoration:

1834 (Gov't. Land Office Notes) Harvey Parke, D.S. -Set post Cor. Sections 24,25- B. Ash 10 S11W 41; Sugar 9 N34W 40
No record of subsequent restoration


B. Description of corner evidence found and/or method applied in restoring or reestablishing corner:

Found 1/2" reinforcing rod over 6"x10"x8" high pointed stone & smallstones and 3/4" inside diameter pipe at depth of 24" over point of stone.

Accepted found markers as marking original corner.

C. Description of monument for corner and accessories established to perpetuate locating the position of the corner:

Removed markers and replaced with Standard Tuscola County Concrete Monument w/ 2" Brass Cap stamped M9 T11N / R11E
N35°E, 54.17' T.C. Remon. tag in SE face of 6" Ash
S35°E, 63.63' T.C. Remon. tag over found nail in West face of power pole
S45°W, 35.99' Set 5/8" diameter rerod
N04°W, 41.30' T.C. Remon. tag over found nail in East face of telephone pole

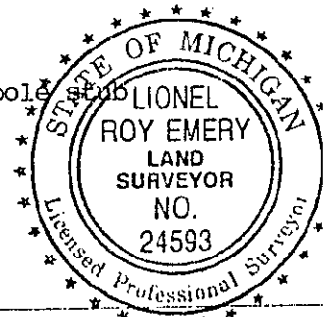

Signed by Lionel Roy Emery Date Aug. 31, 1994

Surveyor's Michigan License No. 24593

APPROVED
3-31-94
[Signature]

COPY

