DEC 07 1994

1994 REMONUMENTATION PROGRAM

9

CUMMISSION

1.41

LAND CORNER RECORDATION CERTIFICATE

Filing	Requirement	of a	Act	74,	Mich.	P.A.	1970

For corners i	n KOYLTON	TOW	NSHIP	ing Requir	ement of Act 74, Mich.	P.A. 1970		RGIS	ं हे	河河	
	SCOLA		Located	ln:	Corner Code -##			ila N COLA TER (6- A 7/72	HO.	نب
1. Public La	ind Survey		T	R 11E R R	M-11_			. MCLAREN COUNTY OF DEEDS	PM 2: 20	# 40	REC
2. Property	_	S	T	. R					<i>G</i>	li	· C
3. Miscellan			T	R			_				
Property			' T			Reg	gister of	Deeds Sta	amp & !	File N	umber
							A B	C D E	F G	H I	J K L
in lines 1 and current manual Management of above were in 6 Court of Law; expressed below.	2 above were in a lot survey instruct by a decree of a conformance with established, report	conform tions of Court of I the rule establis	ance with re the United S Law and/ort s of the Mich hed, monu	egulations an States Depart hat the corne higan Board c mented, re-n	of 1970, the corner points med d rules therefore as required timent of the Interior, Bureau in it points mentioned in lines 3, of Land Surveyors or by a Dec nonumented, recovered, for and range, may be recorde	d in the of Land 4 and 5 ree of a und as	6 — 18 7 8 — 19 9 — 10 — 30	20-	21	22	23
	is certificate.				3 .,,		1231	32	-33	34-	-353
1834 (Gov 19; 1972 (Sur 68.0 N459 1972 (Sur acce 1972 (Lar	y't. Land On Birch 10 No rvey -Liber 03' nail in PW 47.00' Fo rvey -Liber essories as	Efice B4W 8 1 of N. si ace or 2 of above	Notes) Surveys ide P.P. n post of Surveys Surveys	Harvey P., Page 3; S20°W hain lin, pages	d/or subsequent restoration arke, D.SSet possible 49) David T. Rowe, 46.92' center cablic k 20 and 21) David T. Rowe,	st Cor. P.S. 11 e box; N . Rowe,	Section 192 -1945°W 3	Found 5/ 39.4' rd	'8" ro 1. sig -same	od- N gn pc mark	120°E ost; cer and
					applied in restoring or rees smooth rod 24"+/-			urface		•	
Accepted	rods as ma	rking	origina	1 corner						•	
								٠.	-		' b

C. Description of monument for corner and accessories established to perpetuate locating the position of the corner: Removed rods and replaced with Standard Tuscola County Concrete Monument w/2" Brass Cap

stamped M11 T11N / R11E N50°E, 67.26' T.C. Remon. tag over found nail in NE face of power pole S38°E, 38.82' set 5/8" x 24" rerod

S45°W, 48.94' T.C. Remon. tag in NW cor. 4x6 tele. pedestal support

N40°W, 46.96' face of chain link fence corner post


-- Aug --- 31 --- 1994 -

FORM APPROVED BY MICHIGAN STATE BOARD OF LAND SURVEYORS, JAN. 28, 1
REVISED MAY 14, 1

Surveyor's Michigan License No. 24593

LIONEL

ROY EMERY LAND SURVEYOR NO. 24593

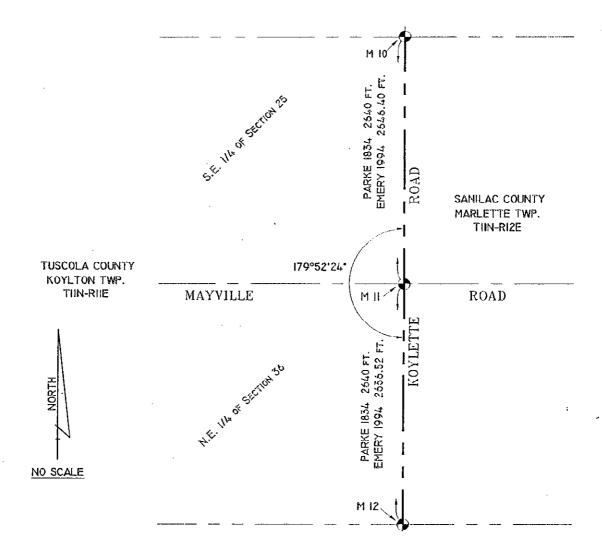

·