

COPY

OCT 20 1994

COMMISSION

1994 REMONUMENTATION PROGRAM
LAND CORNER RECORDATION CERTIFICATE
Filing Requirement of Act 74, Mich. P.A. 1970

For corners in Koylton Township

TUSCOLA (County)	Located In:	Corner Code #
1. Public Land Survey	T <u>11N</u> R <u>11E</u>	<u>M-13</u>
	T _____ R _____	_____
	T _____ R _____	_____
	T _____ R _____	_____
2. Property Controlling in Section	S _____ T _____ R _____	_____
	S _____ T _____ R _____	_____
3. Miscellaneous Property in Sec.	S _____ T _____ R _____	_____

RECEIVED FOR RECORD
LIBERNO. PAGE NO. _____
FILING NO. # 29
94 AUG 19 AM 11:14
Koylton
VIRGINIA H. MCLANER
TUSCOLA COUNTY
REGISTER OF DEEDS

Register of Deeds Stamp & File Number

- 4. Lot No. _____, Recorded Plat _____
- 5. Private Claims _____

	A	B	C	D	E	F	G	H	I	J	K	L	M
2	6		5		4		3		2		1		
3													
4	7		8		9		10		11		12		
5													
6	18		17		16		15		14		13		
7													
8	19		20		21		22		23		24		
9													
10	30		29		28		27		26		25		
11													
12	31		32		33		34		35		36		
13													

I, Kenneth D. Dunton in a field survey on May 28, 19 94, do hereby certify that under requirements of P.A. 74, Michigan P.A. of 1970, the corner points mentioned in lines 1 and 2 above were in conformance with regulations and rules therefore as required in the current manual of survey instructions of the United States Department of the Interior, Bureau of Land Management or by a decree of a Court of Law and/or that the corner points mentioned in lines 3, 4 and 5 above were in conformance with the rules of the Michigan Board of Land Surveyors or by a Decree of a Court of Law; established, re-established, monumented, re-monumented, recovered, found as expressed below:

NOTE: Not more than 4 corners, all in the same town and range, may be recorded on this certificate.

A. Description of original monument and accessories and/or subsequent restoration:

1834 G.L.O. Notes	1957-59 M.S.H.D. road plans
Harvey Parke, D.S.	Proj. No. 44081 & 74071 Sheet 13.
Set post corner of Towns	Sta. 400+65.06 1/2" bar
11 North, Ranges 11 & 12 East.	N58°E 52.55' 30" maple
Hemlock 16" N58°W 26 links	S68°E 70.51' 24" maple
Hemlock 11" N37°E 30 links	S45°W 23.49' 8" maple
Notes dated January 13th, 1834	

Witness Card
Date unknown
Delamater-Muschell Engr. & Land Surveyors
Cheboygan, MI
Object & witnesses same as 57-59 M.S.H.D. road plans.

Section A continued on back of this form.


B. Description of corner evidence found and/or method applied in restoring or reestablishing corner:

Found boat spike in monument box and accepted as the best evidence of the original corner.

C. Description of monument for corner and accessories established to perpetuate locating the position of the corner:

Removed boat spike and replaced with 18" x 5/8" rod & 2" standard brass cap in concrete.
Stamped cap corner M-13, T11N-R11E.
N36°54'E 60.93' found M.S.H.D. tag & spike in W. face p. pole.
N36°54'E 42.80' found #11192 tag & spike in SW face corner post.
S47°11'E 28.07' set 1/2" rod & cap #23503 in road shoulder.
S14°08'W 29.89' chiseled "+" atop E. end of 24" conc. drive culvert.
S64°28'W 70.27' found M.S.H.D. tag & double head nail in NW face of phone pole. Set T. C.
Remon. tag & spike above M.S.H.D. tag.


Signed by [Signature] Date Aug. 1, 1994
Surveyor's Michigan License No. 23503
APPROVED
8-1-94

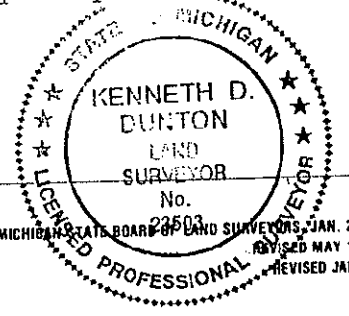

COPY

Section A continued:

Aug. 21, 1991 Unrecorded survey by Russell L. Brown, R.L.S. #24588. Project #91-96.
Found boat spike in mon. box. N40°E 42.53' R.L.S. #11192 tag in p.p.
S65°W 70.10' R.L.S. #11192 tag in t.p.
N42°E 41.88' road sign post.

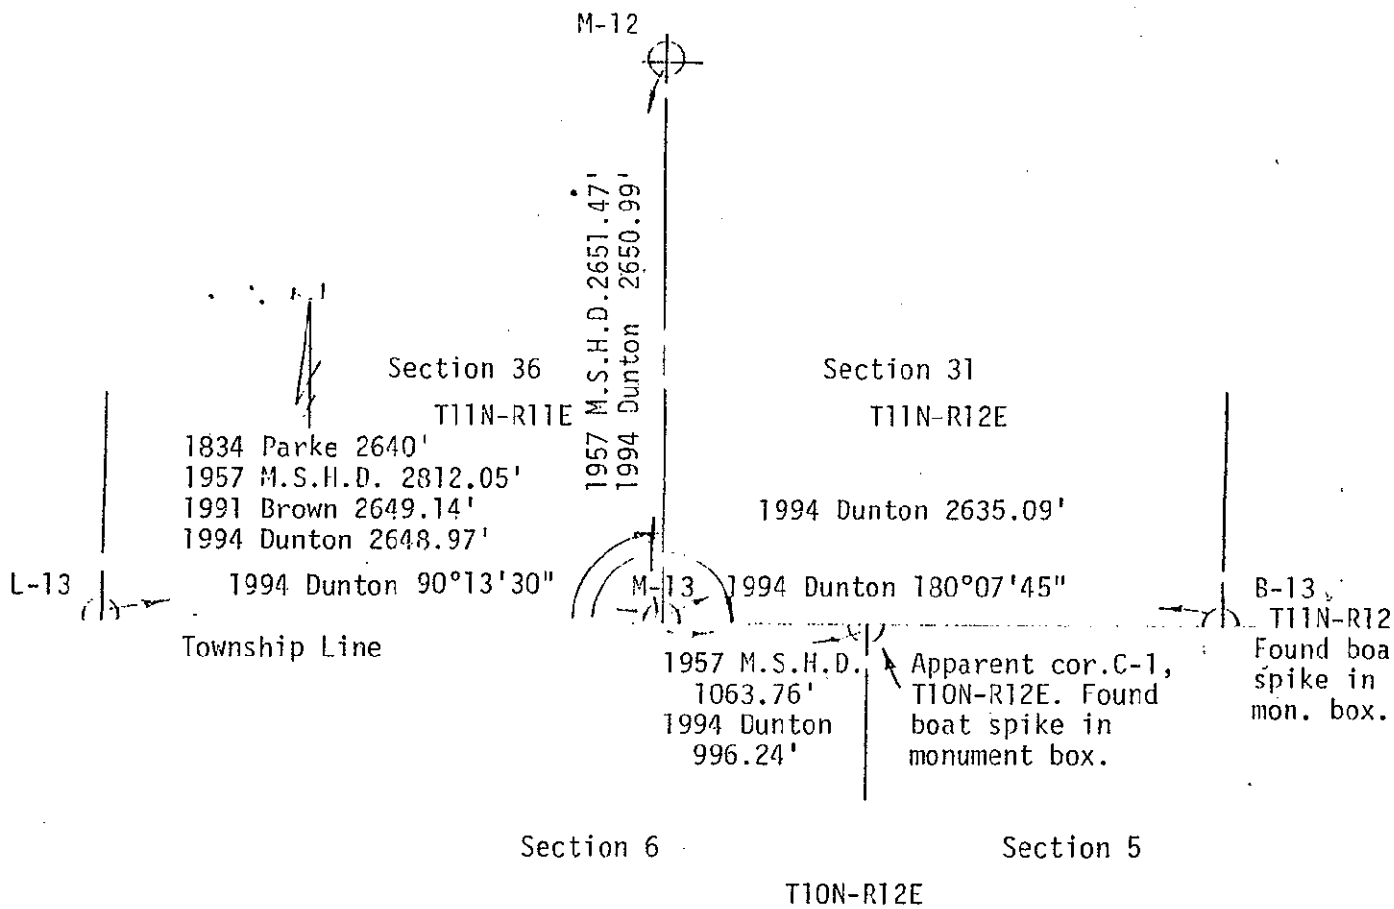

FOR A

FIG 1