

1995 REMONUMENTATION PROGRAM
LAND CORNER RECORDATION CERTIFICATE
 Filing Requirement of Act 74, Mich. P.A. 1970

RECEIVED FOR RECORD
 LIBER NO. _____ PAGE NO. _____
 FILING NO. #59
 DENMARK TWP
 95 NOV -9 PM 3:37
 VIRGINIA H. MELAREN
 TUSCOLA COUNTY
 REGISTER OF DEEDS

For corners in Denmark Township

<u>Tuscola</u> (County)	Located In:	Corner Code #
1. Public Land Survey	T <u>12N</u> R <u>7E</u>	<u>A-13</u>
	T _____ R _____	_____
	T _____ R _____	_____
	T _____ R _____	_____
2. Property Controlling in Section	S _____ T _____ R _____	_____
	S _____ T _____ R _____	_____
3. Miscellaneous Property in Sec.	S _____ T _____ R _____	_____
	S _____ T _____ R _____	_____
4. Lot No. _____, Recorded Plat _____		
5. Private Claims _____		

Register of Deeds Stamp & File Number

I, Kenneth D. Dunton, in a field survey on September 2, 19 95, do hereby certify that under requirements of P.A. 74, Michigan P.A. of 1970, the corner points mentioned in lines 1 and 2 above were in conformance with regulations and rules therefore as required in the current manual of survey instructions of the United States Department of the Interior, Bureau of Land Management or by a decree of a Court of Law and/or that the corner points mentioned in lines 3, 4 and 5 above were in conformance with the rules of the Michigan Board of Land Surveyors or by a Decree of a Court of Law: established, re-established, monumented, re-monumented, recovered, found as expressed below:

NOTE: Not more than 4 corners, all in the same town and range, may be recorded on this certificate.

	A	B	C	D	E	F	G	H	I	J	K	L	M
2	6		5		4		3		2		1		
3													
4	7		8		9		10		11		12		
5													
6	13		17		16		15		14		13		
7													
8	19		20		21		22		23		24		
9													
10	30		29		28		27		26		25		
11													
12	31		32		33		34		35		36		
13													

A. Description of original monument and accessories and/or subsequent restoration:

Feb. 19, 1834 G.L.O. Notes
 Orange Risdon, D. S.
 to township corner.
 One bearing tree dead and
 took another.
 Beech 16" N61W 59-Links

April, of 1972 by Harold W. Dorcey, R.L.S. #9429 Act 74
 Form filed on Page 4 Denmark Township. Found monument
 box in pavement, no witnesses.
 May of 1972 Survey by Harold W. Dorcey, R.L.S. #9429
 recorded in Liber 2 Page 306 Tuscola County Records.
 Found monument box in pavement. No witnesses given.

B. Description of corner evidence found and/or method applied in restoring or reestablishing corner:

Found 7/8" iron bar in monument box and accepted as the proper position of Corner A-13.

SURVEY &
 RECORDATION

DEC 1 1995

COPY

C. Description of monument for corner and accessories established to perpetuate locating the position of the corner:

Placed standard brass cap stamped Corner A-13, T12N-R7E over found iron bar. Encased cap & iron bar in concrete in monument box.


S54°23'E 26.52' chiseled notch atop S. end 40' CSP arch under road.
 N41°40'E 32.61' fnd. chiseled notch atop N. end 40' CSP arch under road.
 S43°32'W 39.62' set T. C. Remon. tag & spike in SE face t. pole.
 N76°12'W 84.80' fnd. nail in S. face p. pole. Set T. C. Remon. tag & spike above
 N57°40'E 59.64' set T. C. Remon. tag & spike in South root 40" cottonwood
 N62°35'E 39.05' set T. C. Remon. tag & spike in South face t. pole.
 West 8' physical centerline N-S pavement.
 North 6' physical centerline E-W pavement.

Signed by [Signature]

Date 10-23-95

Surveyor's Michigan License No. 23503

APPROVED
10-23-95
 [Signature]

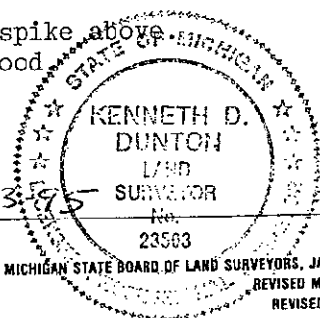

FORM APPROVED BY MICHIGAN STATE BOARD OF LAND SURVEYORS, JAN. 28, 1974
 REVISED MAY 14, 1975
 REVISED JAN., 1983

