

1995 REMONUMENTATION PROGRAM
LAND CORNER RECORDATION CERTIFICATE
 Filing Requirement of Act 74, Mich. P.A. 1970

For corners in Denmark Township

<u>Tuscola</u> <small>(County)</small>	Located In:	Corner Code #
1. Public Land Survey	T <u>12N</u> R <u>7E</u>	<u>B-13</u>
	T _____ R _____	_____
	T _____ R _____	_____
	T _____ R _____	_____
2. Property Controlling in Section	S _____ T _____ R _____	_____
	S _____ T _____ R _____	_____
3. Miscellaneous Property in Sec.	S _____ T _____ R _____	_____
	S _____ T _____ R _____	_____
4. Lot No. _____, Recorded Plat _____		
5. Private Claims _____		

RECEIVED FOR RECORD
 LIBER NO. _____ PAGE NO. _____
 FILING NO. #40
 DENMARK TWP.
 95 NOV -9 PM 3:37
 VIRGINIA N. McLEAREN
 TUSCOLA COUNTY
 REGISTER OF DEEDS

Register of Deeds Stamp & File Number

	A	B	C	D	E	F	G	H	I	J	K	L	M
2	6	5	4	3	2	1							
3													
4	7	8	9	10	11	12							
5													
6	18	17	16	15	14	13							
7													
8	19	20	21	22	23	24							
9													
10	30	29	28	27	26	25							
11													
12	31	32	33	34	35	36							
13													

Kenneth D. Dunton, in a field survey on Sept. 2, 19 95, do hereby certify that under requirements of P.A. 74, Michigan P.A. of 1970, the corner points mentioned in lines 1 and 2 above, were in conformance with regulations and rules therefore as required in the current manual of survey instructions of the United States Department of the Interior, Bureau of Land Management or by a decree of a Court of Law and/or that the corner points mentioned in lines 3, 4 and 5 above were in conformance with the rules of the Michigan Board of Land Surveyors or by a Decree of a Court of Law; established, re-established, monumented, re-monumented, recovered, found as expressed below:

NOTE: Not more than 4 corners, all in the same town and range, may be recorded on this certificate.

A. Description of original monument and accessories and/or subsequent restoration:

Feb. 19, 1834 G.L.O. Notes
 Orange Risdon, D.S.
 Set 1/4 Section Post
 Beech 10" N39E 59 Links
 Beech 12" N35W 13 Links

April of 72 Act 74 Form filed by Harold W. Dorsey, R.L.S. #9429 on Page 4, Denmark Township. Found p.k. nail in blacktop replaced with boat spike. No accessories given. May of 1972 Survey by Harold W. Dorsey, R.L.S. #9429, recorded in Liber, Page 306, Tuscola County Records. Same data as Act 74 Form, Page 4, Denmark Township. May 27, 1985 Survey by K. D. Dunton, R.L.S. #23503, recorded in Liber 553, Page 484, Tuscola County Records. Found spike. North 8' centerline E-W pave., West 84.5' remains of fence line South.

B. Description of corner evidence found and/or method applied in restoring or reestablishing corner:

Found 3/4" pipe, also found boat spike 6.15' West. Found no other evidence below spike or pipe. Accepted the 3/4" pipe as the proper position of Corner B-13 as it falls 0.32' East of the 1995 mile measure, proportioned to the 1834 mile measure by Risdon.

SURVEY &
 DEC. 1995
 COMMISSION

COPY

C. Description of monument for corner and accessories established to perpetuate locating the position of the corner:

Removed 3/4" pipe and placed concrete monument with standard brass cap stamped Corner B-13, T12N-R7E. Placed monument box over monument.


S45°07'E 8.01' set 1/2" x 18" re-rod in road shoulder.
 S44°53'W 8.38' set 1/2" x 18" re-rod in road shoulder.
 N45°07'W 30.39' set 1/2" x 18" re-rod in road shoulder.
 N44°53'E 30.85' set 1/2" x 18" re-rod in road shoulder.
 North 7.65' physical centerline E-W pavement.
 N89°53'W 6.15' found boat spike by Dorsey.

Signed by [Signature]

Date 10-23-95

Surveyor's Michigan License No. 23503

APPROVED
 10-23-95

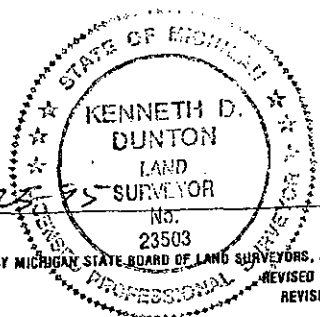

FORM APPROVED BY MICHIGAN STATE BOARD OF LAND SURVEYORS, JAN. 28, 1971
 REVISED MAY 14, 1975
 REVISED JAN., 1983

