

1995 REMONUMENTATION PROGRAM
LAND CORNER RECORDATION CERTIFICATE
 Filing Requirement of Act 74, Mich. P.A. 1970

For corners in Denmark Township

<u>Tuscola</u> <small>(County)</small>	Located In:	Corner Code #
1. Public Land Survey	T <u>12N</u> R <u>7E</u>	<u>C-13</u>
	T _____ R _____	_____
	T _____ R _____	_____
	T _____ R _____	_____
2. Property Controlling in Section	S _____ T _____ R _____	_____
	S _____ T _____ R _____	_____
3. Miscellaneous Property in Sec.	S _____ T _____ R _____	_____
	S _____ T _____ R _____	_____

RECEIVED FOR RECORD
 LIBER NO. _____ PAGE NO. _____
 FILING NO. #61
 DENMARK TWP.
 95 NOV -9 PM 3:37
 VIRGINIA M. HOLLAREN
 TUSCOLA COUNTY
 REGISTER OF DEEDS

Register of Deeds Stamp & File Number

4. Lot No. _____, Recorded Plat _____
 5. Private Claims _____

A	B	C	D	E	F	G	H	I	J	K	L	M
2	6	5	4	3	2	1						
3												
4	7	8	9	10	11	12						
5												
6	18	17	16	15	14	13						
7												
8	19	20	21	22	23	24						
9												
10	30	29	28	27	26	25						
11												
12	31	32	33	34	35	36						
13												

I, Kenneth D. Dunton, in a field survey on September 2, 19 95, do hereby certify that under requirements of P.A. 74, Michigan P.A. of 1970, the corner points mentioned in lines 1 and 2 above were in conformance with regulations and rules therefore as required in the current manual of survey instructions of the United States Department of the Interior, Bureau of Land Management or by a decree of a Court of Law and/or that the corner points mentioned in lines 3, 4 and 5 above were in conformance with the rules of the Michigan Board of Land Surveyors or by a Decree of a Court of Law; established, re-established, monumented, re-monumented, recovered, found as expressed below:

NOTE: Not more than 4 corners, all in the same town and range, may be recorded on this certificate.

A. Description of original monument and accessories and/or subsequent restoration:

Feb. 19, 1834 G.L.O. Notes
 Orange Risdon, D.S.
 Set Post Corner of Sections 31 & 32
 Sugar 14" N27E 45 Links
 Sugar 12" S23E 2 Links

April of 1972 Act 74 Form filed by Harold W. Dorsey, R.L.S. #9429 on Page 4 Denmark Township. Found old axle with hex nut. Set boat spike on top to surface. Nail N.E. side 16" maple S.S.E. 40.00 feet, nail side power pole W.S.W. 79.78 ft., nail W. side power pole N.E. 41.62 feet. May of 1972 Survey by Harold W. Dorsey, R.L.S. #9429, recorded in Liber 2, Page 306 Tuscola County Records. Same witnesses as Act 74 Form, Page 4, Denmark Township.

Section A continued on back of form.

B. Description of corner evidence found and/or method applied in restoring or reestablishing corner:

Found 2" pipe with 3" hex nut atop with 3/4" hole in center hex nut. Accepted evidence found as the proper position of Corner C-13.

SURVEY &
 DENMARK TOWNSHIP
 DEC 1 1995
 COMMISSION


COPY

C. Description of monument for corner and accessories established to perpetuate locating the position of the corner:

Placed 5/8" re-rod with standard brass cap stamped corner C-13, T12N-R7E in center of pipe & hex nut. Placed monument box and encased 2" pipe, 5/8" re-rod & brass cap in concrete in monument box.
 S48°32'E 21.70' chiseled notch atop W. end 48" x 22' CSP drive culvert.
 S62°11'E 40.00 set T. C. Remon. tag & spike in NE face 30" maple.
 N72°08'W 79.75' fnd. P.K. nail in SW face p. pole. Set T. C. Remon. tag & spike above.
 N48°29'E 41.62' fnd. spike in NW face p. pole. Set T. C. Remon. tag & spike above.
 North 6.5' physical centerline E-W pavement.

Signed by [Signature] Date 10-23-95
 Surveyor's Michigan License No. 23503

APPROVED
10-23-95

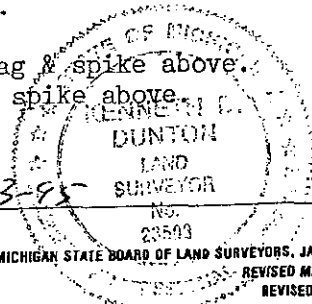

Section A continued:

May 27, 1985 Survey by K. D. Dunton, R.L.S. #23503, recorded Liber 553, Page 484, Tuscola County Records. Found spike. N45°E 41.62' p. pole, S20°E 40.00' 16" maple, N80°W 79.70' p. pole.

