

1995 REMONUMENTATION PROGRAM  
**LAND CORNER RECORDATION CERTIFICATE**  
 Filing Requirement of Act 74, Mich. P.A. 1970

RECEIVED FOR RECORDING  
 LIBER. NO. \_\_\_\_\_ PAGE NO. \_\_\_\_\_  
 FILING NO. # 62  
 DENMARK TWP.  
 95 NOV -9 PM 3:37  
 VIRGINIA M. McLAUREN  
 TUSCOLA COUNTY  
 REGISTER OF DEEDS

For corners in Denmark Township

<u>Tuscola</u> (County)	Located In:	Corner Code #
1. Public Land Survey	T <u>12N</u> R <u>7E</u>	<u>D-13</u>
	T _____ R _____	_____
	T _____ R _____	_____
	T _____ R _____	_____
2. Property Controlling in Section	S _____ T _____ R _____	_____
	S _____ T _____ R _____	_____
3. Miscellaneous Property in Sec.	S _____ T _____ R _____	_____
	S _____ T _____ R _____	_____

Register of Deeds Stamp & File Number

4. Lot No. \_\_\_\_\_, Recorded Plat \_\_\_\_\_  
 5. Private Claims \_\_\_\_\_

	A	B	C	D	E	F	G	H	I	J	K	L	M
2	6	5	4	3	2	1							
3													
4	7	8	9	10	11	12							
5													
6	18	17	16	15	14	13							
7													
8	19	20	21	22	23	24							
9													
10	30	29	28	27	26	25							
11													
12	31	32	33	34	35	36							
13													

I, Kenneth D. Dunton, in a field survey on September 2, 19 95, do hereby certify that under requirements of P.A. 74, Michigan P.A. of 1970, the corner points mentioned in lines 1 and 2 above were in conformance with regulations and rules therefore as required in the current manual of survey instructions of the United States Department of the Interior, Bureau of Land Management or by a decree of a Court of Law and/or that the corner points mentioned in lines 3, 4 and 5 above were in conformance with the rules of the Michigan Board of Land Surveyors or by a Decree of a Court of Law; established, re-established, monumented, re-monumented, recovered, found as expressed below:

**NOTE: Not more than 4 corners, all in the same town and range, may be recorded on this certificate.**

A. Description of original monument and accessories and/or subsequent restoration:

Feb. 19, 1834 G.L.O. Notes  
 Orange Risdon, D.S.  
 Set 1/4" Section Post  
 Beech 12" N50E 22 Links  
 Hickory 12" N42W 26 Links

Sept. 24, 1981 Act 74 form filed by Ronald C. Prevost, R.L.S. #24612. Found 1" sq. head bolt 8" below bit. N45°W 39.90' center street sign post, N45°E 36.02' face t. pole, S15°W 119.74' NE cor. brick house, S60°E 80.40' face p. & t. pole.  
 June 10, 1982 Survey by Richard R. Boldt, R.L.S. #28405 with Rowe Eng., recorded in Liber 526, Page 001, Tuscola County Records. Found 1" sq. iron N45°E 36.54' p. k. nail in SE face t.p., S. 50°E 80.85' p. k. nail in NE face p.p., N45°W 40.09' base of road sign post.

Section A continued on back of form.

B. Description of corner evidence found and/or method applied in restoring or reestablishing corner:

Found 1" square bolt with cross chiseled atop. Accepted evidence found as the proper position of Corner D-13.

DEPARTMENT OF  
 LAND SURVEYING  
 DECEMBER 1995  
 COMMISSION

COPY

C. Description of monument for corner and accessories established to perpetuate locating the position of the corner:

Removed 1" bolt/<sup>30" long</sup> and placed concrete monument with standard brass cap stamped corner D-13, T12N-R7E. Placed monument box over monument.

S65°50'E 80.95' fnd. P.K. nail in NE face p. pole. Set T. C. Remon. tag & spike above.  
 S59°34'E 60.86' set T. C. Remon. tag & spike in SW face new p. pole.  
 N45°53'W 50.70' set T. C. Remon. tag & spike in SW face new p. pole.  
 N49°53'E 36.44' fnd. P.K. nail in SE face t. p. stub pole. Set T. C. Remon. tag & spike above.  
 S15°28'W 119.62' NE corner brick garage @ #9251.

Signed by [Signature]


Date 10-23-95

Surveyor's Michigan License No. 23503

APPROVED

10-23-95 [Signature]

FORM APPROVED BY MICHIGAN STATE BOARD OF LAND SURVEYORS, JAN. 28, 1971  
 REVISED MAY 14, 1975  
 REVISED JAN., 1983

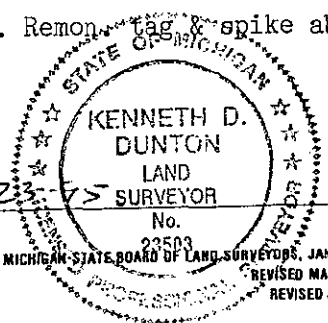

Section A continued:

November 11, 1982 Survey by Richard R. Boldt, R.L.S. #28405 with Rowe Engineering, recorded in Liber 536, Page 1329 Tuscola County Records. Same witnesses as Liber 526, Page 001.

