

1995 REMONUMENTATION PROGRAM
LAND CORNER RECORDATION CERTIFICATE
 Filing Requirement of Act 74, Mich. P.A. 1970

RECEIVED FOR RECORD
 LIBER NO. _____ PAGE NO. _____
 FILING NO. #607
 DENMARK TWP
 95 NOV -9 PM 3:37
 VIRGINIA H. McARDER
 TUSCOLA COUNTY
 REGISTER OF DEEDS

For corners in Denmark Township

<u>Tuscola</u> <small>(County)</small>	Located In:	Corner Code =#
1. Public Land Survey	T <u>12N</u> R <u>7E</u>	<u>I-13</u>
	T _____ R _____	_____
	T _____ R _____	_____
	T _____ R _____	_____
2. Property Controlling in Section	S _____ T _____ R _____	_____
	S _____ T _____ R _____	_____
3. Miscellaneous Property in Sec.	S _____ T _____ R _____	_____
	S _____ T _____ R _____	_____

Register of Deeds Stamp & File Number

4. Lot No. _____, Recorded Plat _____
 5. Private Claims _____

	A	B	C	D	E	F	G	H	I	J	K	L	M
2	6	5	4	3	2								
3													
4	7	8	9	10	11	12							
5													
6	18	17	16	15	14	13							
7													
8	19	20	21	22	23	24							
9													
10	30	29	28	27	26	25							
11													
12	31	32	33	34	35	36							
13													

I, Kenneth D. Dunton, in a field survey on August 20, 19 95, do hereby certify that under requirements of P.A. 74, Michigan P.A. of 1970, the corner points mentioned in lines 1 and 2 above were in conformance with regulations and rules therefore as required in the current manual of survey instructions of the United States Department of the Interior, Bureau of Land Management or by a decree of a Court of Law and/or that the corner points mentioned in lines 3, 4 and 5 above were in conformance with the rules of the Michigan Board of Land Surveyors or by a Decree of a Court of Law, established, re-established, monumented, re-monumented, recovered, found as expressed below:

NOTE: Not more than 4 corners, all in the same town and range, may be recorded on this certificate.

A. Description of original monument and accessories and/or subsequent restoration:

Feb. 19, 1834 G.L.O. Notes
 Orange Risdon, D.S.
 Set Post Corner of Section 34 & 35
 White Oak 24" N13W 22 Links
 White Maple 40" N85E 51 Links

May 5, 1975 Act 74 Form filed by James A. Beck, R.L.S. #21559 on Page 33, Denmark Township. Found 1" iron bar, raised with 1/2" re-rod. N45°W 38.43' R.L.S. #11192 tag in t.p., S40°E 34.6' S. end 50.5' of 30" CMP, N50°E 34.6' N. end 50.5' of 30" CMP.

May 12, 1975 Survey by James A. Beck, R.L.S. #21559 with Rowe Engineering recorded in Liber 452 Page 599 Tuscola County Records. 1" iron bar. Accessories the same as Act

Section A continued on back of this form. 74 Form filed on Page 33 Denmark Township.

B. Description of corner evidence found and/or method applied in restoring or reestablishing corner:

Found 1/2" x 18" re-rod and 1" x 32" axle shaft below 1/2" re-rod. Accepted evidence found as the proper position of Corner I-13.

SURVEY &
 REMONUMENTATION

DEC 6 1995

COMMISSION

COPY

C. Description of monument for corner and accessories established to perpetuate locating the position of the corner:

Removed two iron rods and placed concrete monument with standard brass cap stamped Corner I-13, T12N-R7E. Placed monument box over monument.

N43°23'W 33.50' set 1/2" x 18" re-rod in road shoulder.
 S57°45'W 27.09' set 1/2" x 18" re-rod in road shoulder.
 N44°12'E 34.68' chiseled notch atop North end 50.5' of 30" CSP crossroad culvert.
 S41°51'E 34.58' chiseled notch atop South end 50.5' of 30" CSP crossroad culvert.


Signed by [Signature]

Date 10-23-95

Surveyor's Michigan License No. 23503

APPROVED
 10-23-95

FORM APPROVED BY MICHIGAN STATE BOARD OF LAND SURVEYORS, JAN. 28, 1971
 REVISED MAY 14, 1975
 REVISED JAN., 1983

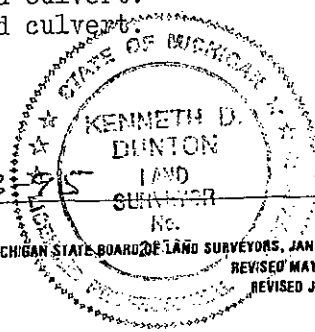

Section A continued:

June 12, 1978 Survey by Lloyd D. McGinnis, R.L.S. #18999 with Edmands Engineering, Inc. Recorded on Liber 488 Page 008, Tuscola County Records. Found 5/8" re-rod. N.E. 34.6' to centerline N. end 30" CMP, S.E. 34.6' to centerline S. end 30" CMP, N.W. 37.5' to st. sign post.

November 26, 1979 Survey by Kenneth D. Dunton, R.L.S. #23503. Recorded in Liber 508 Page 842, Tuscola County Records. Found 1/2" rod in place. N45°W 45.6' tele. junction box, S45°E 34.8' S. end 50' x 30" CMP, N45°E 34.8' N. end 50' x 30" CMP.

May 29, 1984 Survey by B. D. Ferguson, R.L.S. #26454 with Hammond Engineering, recorded in Liber 541 Page 1022 & 1023, Tuscola County Records. No mention of object set or found or accessories.

