1995 REMONUMENTATION PROGRAM

LAND CORNER RECORDATION CERTIFICATE

Filing Requirement of Act 74, Mich. P.A. 1970

RECEIVED FOR RECORD
LIBER NO. ____ PAGE NO. ____
FILING NO. #69
DENMARK TWP.
95 NOV -9 PM 3:37
VIRGINIA M. MOLARCK
TUSCOLA COUNTY
REGISTER OF DEEDS

For corners in Denmark Township

Tuscola (County) Located In: Corner Code ##

1. Public Land Survey		T 12N R 7E	K-13
		T ____ R ____	
		T ____ R ____	
		T ____ R ____	
2. Property Controlling	S ____	T ____ R ____	
in Section	S ____	T ____ R ____	
3. Miscellaneous	S ____	T ____ R ____	
Property in Sec.	S ____	T ____ R ____	

Register of Deeds Stamp & File Number

4. Lot No. _____ , Recorded Plat _____
5. Private Claims _____

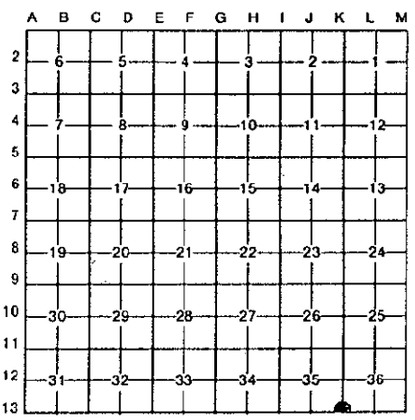

I, Kenneth D. Dunton in a field survey on August 13, 19 95, do hereby certify that under requirements of P.A. 74, Michigan P.A. of 1970, the corner points mentioned in lines 1 and 2 above were in conformance with regulations and rules therefore as required in the current manual of survey instructions of the United States Department of the Interior, Bureau of Land Management or by a decree of a Court of Law and/or that the corner points mentioned in lines 3, 4 and 5 above were in conformance with the rules of the Michigan Board of Land Surveyors or by a Decree of a Court of Law; established, re-established, monumented, re-monumented, recovered, found as expressed below:

NOTE: Not more than 4 corners, all in the same town and range, may be recorded on this certificate.

A. Description of original monument and accessories and/or subsequent restoration:

Feb. 18, 1834 G.L.O. Notes
Orange Risdon, D.S.
Set Post Corner to Secs. 35 & 36
Black Ash 10" N41E 18 Links
White Oak 18" N50W 38 Links

B. Description of corner evidence found and/or method applied in restoring or reestablishing corner:

Found 3/8" x 18" re-rod with 27" x 5/8" hooked rod below, also rock pile and wood post at 24" deep. 5/8" rod was in center of wood post. Accepted evidence found as the proper position of Corner K-13.

SURVEY & MONUMENTATION
DEC 1995
COMMISSION

COPY

C. Description of monument for corner and accessories established to perpetuate locating the position of the corner:

Removed two iron rods and placed concrete monument with standard brass cap stamped Corner K-13, T12N-R7E in center of wood post. Placed monument box over monument.

S42°21'W 31.32' set 1/2" x 18" re-rod in road shoulder.
N47°24'W 29.08' set 1/2" x 18" re-rod in road shoulder.
S47°21'E 41.04' set T. C. Remon. tag & spike over P.K. nail found in SW face p. pole.
N22°57'E 72.35' set T. C. Remon. tag & spike over P.K. nail found in NW face p. pole.
South 7.0' physical centerline of E-W pavement.

Signed by _____ Date 10-23-95

Surveyor's Michigan License No. 23503

APPROVED 10-23-95 J.M.T. J.R.E.

STATE OF MICHIGAN LICENSED PROFESSIONAL SURVEYOR KENNETH D. DUNTON LAND SURVEYOR No. 23503

FORM APPROVED BY MICHIGAN STATE BOARD OF LAND SURVEYORS, JAN. 28, 1971
REVISED MAY 14, 1975
REVISED JAN., 1983

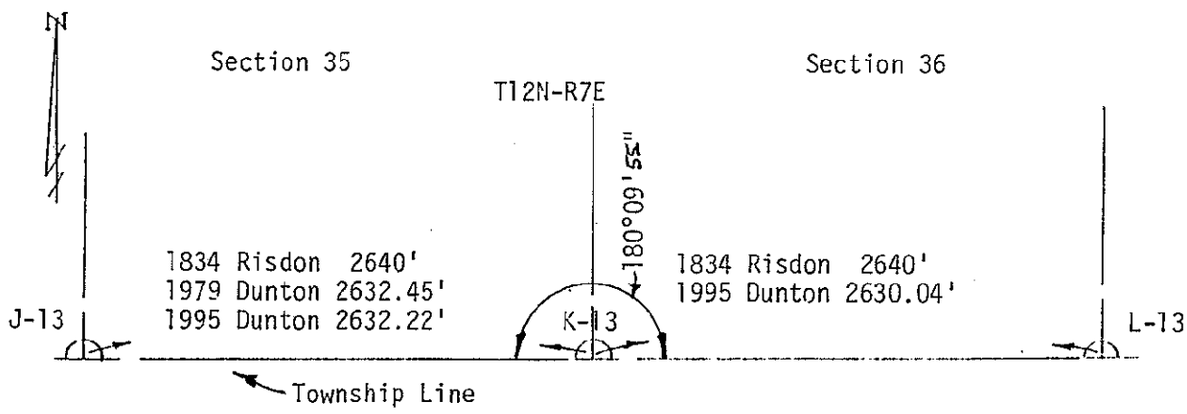
N
Section 35
Section 36
T12N-R7E
180°09'55"
1834 Risdon 2640'
1979 Dunton 2632.45'
1995 Dunton 2632.22'
1834 Risdon 2640'
1995 Dunton 2630.04'
J-13
K-13
L-13
Township Line