

1995 REMONUMENTATION PROGRAM
LAND CORNER RECORDATION CERTIFICATE
 Filing Requirement of Act 74, Mich. P.A. 1970

RECEIVED FOR RECORD
 LIBER NO. _____ PAGE NO. _____
 FILING NO. #71
 DENMARK TWP.
 95 NOV 21 PM 2: 59
 VIRGINIA H. McLAUGHLIN
 TUSCOLA COUNTY
 REGISTER OF DEEDS

For corners in Denmark Township

Tuscola (County)	Located In:	Corner Code #
1. Public Land Survey	T <u>12N</u> R <u>7E</u>	<u>M-1</u>
	T _____ R _____	_____
	T _____ R _____	_____
	T _____ R _____	_____
2. Property Controlling in Section	S _____ T _____ R _____	_____
	S _____ T _____ R _____	_____
3. Miscellaneous Property in Sec.	S _____ T _____ R _____	_____
	S _____ T _____ R _____	_____

Register of Deeds Stamp & File Number

4. Lot No. _____, Recorded Plat _____
 5. Private Claims _____

	A	B	C	D	E	F	G	H	I	J	K	L	M
2	6	5	4	3	2								
3													
4	7	8	9	10	11	12							
5													
6	16	17	16	15	14	13							
7													
8	19	20	21	22	23	24							
9													
10	30	29	28	27	26	25							
11													
12	31	32	33	34	35	36							
13													

I, Kenneth D. Dunton, in a field survey on October 21, 19 95, do hereby certify that under requirements of P.A. 74, Michigan P.A. of 1970, the corner points mentioned in lines 1 and 2 above were in conformance with regulations and rules therefore as required in the current manual of survey instructions of the United States Department of the Interior, Bureau of Land Management or by a decree of a Court of Law and/or that the corner points mentioned in lines 3, 4 and 5 above were in conformance with the rules of the Michigan Board of Land Surveyors or by a Decree of a Court of Law; established, re-established, monumented, re-monumented, recovered, found as expressed below:

NOTE: Not more than 4 corners, all in the same town and range, may be recorded on this certificate.

A. Description of original monument and accessories and/or subsequent restoration:

1834 G.L.O. Notes Orange Risdon, D.S. Intersected town line 38.87 ch. (2565.42') west of 1/4 section corner. W. Oak 14 N43W 33L Beech 12 S54E 52L Elm 10 N23E 4L Section A continued on back of this form.	Feb. 23, 1983 Act 74 form filed by Richard R. Boldt, L.S. #28405, on Page 45 Juniata Township. Fnd. 5/8" re-rod. N25°W 65.35' chis. "X" on top large rock, S45°W 25.70' chis. "X" on W. end 26" C.M.P., N50°E 40.09' chis. "X" on road sign post, N45°E 147.42' SW cor. brick face house. Note: This corner is common to Sec. 1 Denmark NE cor; SE cor. Sec. 36 Gilford Township and Sec. 31, Fairgrove Twp. SW cor.
--	--

B. Description of corner evidence found and/or method applied in restoring or reestablishing corner:

Found 5/8" rod in place, also found 1 1/4" x 36" pipe below 5/8" rod and remains of wood post and rocks. Accepted 5/8" rod as the proper position of Corner M-1.


C. Description of monument for corner and accessories established to perpetuate locating the position of the corner:

Removed 5/8" rod, 1 1/4" pipe & wood post. Placed concrete monument with standard brass cap stamped Corner M-1, T12N-R7E. Placed monument box over monument.
 S51°40'W 25.60' chiseled "+" atop West end 50' of 30" C.S.P.
 N30°19'W 65.21' fnd. "+" chiseled atop large rock (24" x 30"+).
 N48°29'E 147.45' SW cor. brick face house #493.
 N49°E 67.0' center 12" pine.
 S58°24'E 34.78' chiseled notch atop East end 50' of 30" C.S.P.

Signed by [Signature] Date Nov 14 1995

Surveyor's Michigan License No. 23503

APPROVED
11-14-95
 [Signatures]

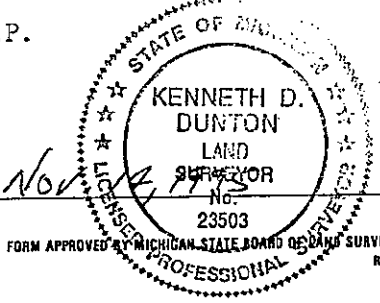

FORM APPROVED BY MICHIGAN STATE BOARD OF LAND SURVEYORS, JAN. 28, 1971
 REVISED MAY 14, 1975
 REVISED JAN., 1983

SUBMITTED TO
 RECORDS SECTION

DEC 01 1995
 COMMISSION

COPY

Section A continued:

Feb. 24, 1983 Survey by R. Boldt, L.S. #28405, recorded in Liber 540, Page 08, Tuscola County Records. No mention of object found or set. Accessories same as Act 74, Page 45 except corner house not used & no note of common corner with adjoining townships.
 August 27, 1985 Survey by Duane F. Ledy, R.L.S. #21575, recorded in Liber 552, Page 1404, Tuscola County Records. 1/2" rebar. SE 25.70' to top 30" ctr. C.M.P., NE 40.05' to rd. sign post, SW 26.00' to top 30" C.M.P.
 Dec. 2, 1988 Survey by Stephan J. Szyszkoski, L.S. #33986 with Rowe Engineering, Inc., recorded in Liber 588 on Page 871, Tuscola County Records. Fnd. 5/8" re-rod.
 N25°W 65.21' fnd. chis. "X" on top large rock, S45°W 25.70' fnd. chis. "X" on W. end 26" C.M.P., N45°E 147.42' SW cor. brick face to house #493, S45°E 22.63' set 1/2" rod w/cap 33986 at edge asphalt.

