

1995 REMONUMENTATION PROGRAM
LAND CORNER RECORDATION CERTIFICATE
 Filing Requirement of Act 74, Mich. P.A. 1970

For corners in Denmark Township

<u>Tuscola</u> <small>(County)</small>	Located In:	Corner Code #
1. Public Land Survey	T <u>12N</u> R <u>7E</u>	<u>M-2</u>
	T _____ R _____	_____
	T _____ R _____	_____
	T _____ R _____	_____
2. Property Controlling in Section	S _____ T _____ R _____	_____
	S _____ T _____ R _____	_____
3. Miscellaneous Property in Sec.	S _____ T _____ R _____	_____
	S _____ T _____ R _____	_____
4. Lot No. _____, Recorded Plat _____		
5. Private Claims _____		

RECEIVED FOR RECORD
 LIBER NO. _____ PAGE NO. _____
 FILING NO. # 72
DENMARK TWP.
 95 NOV 21 PM 2:59
 VIRGINIA H. McLAUGH
 TUSCOLA COUNTY
 REGISTER OF DEEDS

Register of Deeds Stamp & File Number

	A	B	C	D	E	F	G	H	I	J	K	L	M
2	5	5			4			3		2		1	
3													
4	7	8			9			10		11		12	
5													
6	18	17			16			15		14		13	
7													
8	19	20			21			22		23		24	
9													
10	30	29			28			27		26		25	
11													
12	31	32			33			34		35		36	
13													

I, Kenneth D. Dunton, in a field survey on October 21, 1995, do hereby certify that under requirements of P.A. 74, Michigan P.A. of 1970, the corner points mentioned in lines 1 and 2 above were in conformance with regulations and rules therefore as required in the current manual of survey instructions of the United States Department of the Interior, Bureau of Land Management or by a decree of a Court of Law and/or that the corner points mentioned in lines 3, 4 and 5 above were in conformance with the rules of the Michigan Board of Land Surveyors or by a Decree of a Court of Law; established, re-established, monumented, re-monumented, recovered, found as expressed below:

NOTE: Not more than 4 corners, all in the same town and range, may be recorded on this certificate.

A. Description of original monument and accessories and/or subsequent restoration:

1834 G.L.O. Notes Orange Risdon Set 1/4 Section Post Beech 10 N20E 4L Beech 10 S43W 46L	October 25, 1973 Survey by David T. Rowe, R.L.S. #11192, recorded in Liber 436, Pages 257 & 258, <u>Tuscola County Records</u> , 5/8" re-rod. S65°E 186.90' R.L.S. #11192 tag in N. leg o.h. power line. South 45.00' boat spike on centerline o.h. power lines East and West. October, 1973 Act 74 form filed on Page 27 Denmark Township. Fnd. 5/8" rod. Same accessories as Liber 436, Pages 257 & 258. Dec. 20, 1974 Act 74 form filed on Page 28, Denmark Township. Fnd. 5/8" rod. Same accessories as Liber 436, Pages 257 & 258.
---	---

B. Description of corner evidence found and/or method applied in restoring or reestablishing corner:

Fnd. p. k. nail - and checked distances of 186.90' to #11192 tag in W. face p.p. & 45'+ to centerline o.h. H-towers. Northwest 4.55' found 1/2 of cast iron stove lid, bricks & ironstone china around 4" square wood post. Post hacked to point. Accepted wood post as the proper position of Corner M-2, T12N-R7E.


C. Description of monument for corner and accessories established to perpetuate locating the position of the corner:

Removed wood post & placed concrete monument with standard brass cap stamped corner M-2, T12N-R7E. Placed monument box over monument.
 S35°16'W 23.00' set 1/2" x 18" re-rod in road shoulder.
 N56°30'W 17.70' set 1/2" x 18" re-rod in road shoulder.
 N58°28'E 19.42' set 1/2" x 18" re-rod in road shoulder.
 S77°55'E 189.70' found #11192 tag & nail in West face N. leg "H" tower.
 S26°19'E 4.55' spike at previous position of p.k. nail found.
 South 49'+ centerline "H" towers E & W.

Signed by [Signature] Date Nov. 14, 1995

Surveyor's Michigan License No. 23503

APPROVED
11-14-95
 [Signature]

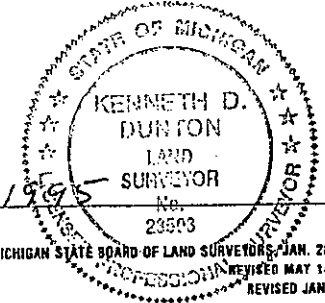

FORM APPROVED BY MICHIGAN STATE BOARD OF LAND SURVEYORS, JAN. 28, 1971
 REVISIONS: REVISIONS MAY 14, 1975
 REVISIONS JAN., 1983

DEC 6 1995
 COMMISSION

COPY



Section 1

1834 Risdon 2640'
1973 D.T.Rowe 2631.64'
Proportion mile measures
1834 to 1995 dist.=2636.20'
1995 Dunton 2635.86'

T12N-R7E

1834 Risdon 2482.92'
Proportion mile measures
1834 to 1995 dist.=2479.34'
1995 Dunton 2479.68'

180°05'15"

Township Line

M-3

M-1

Township Line

Section 36
T13N-R7E

Section 31
T13N-R8E

Section 6

T12N-R8E