

1995 REMONUMENTATION PROGRAM
LAND CORNER RECORDATION CERTIFICATE
 Filing Requirement of Act 74, Mich. P.A. 1970

For corners in Denmark Township
Tuscola
(County)

Located In: _____ Corner Code # _____

- | | | |
|------------------------------------|--------------------------|------------|
| 1. Public Land Survey | T <u>12N</u> R <u>7E</u> | <u>M-3</u> |
| | T _____ R _____ | _____ |
| | T _____ R _____ | _____ |
| | T _____ R _____ | _____ |
| 2. Property Controlling in Section | S _____ T _____ R _____ | _____ |
| | S _____ T _____ R _____ | _____ |
| 3. Miscellaneous Property in Sec. | S _____ T _____ R _____ | _____ |
| | S _____ T _____ R _____ | _____ |

4. Lot No. _____, Recorded Plat _____
 5. Private Claims _____

RECEIVED FOR RECORD
 LIBER NO. _____ PAGE NO. _____
 FILING NO. # 73
DENMARK TWP
 95 NOV 21 PM 2:59
 VIRGINIA H. McLAUREN
 TUSCOLA COUNTY
 REGISTER OF DEEDS

Register of Deeds Stamp & File Number

I, Kenneth D. Dunton, in a field survey on October 21, 19 95, do hereby certify that under requirements of P.A. 74, Michigan P.A. of 1970, the corner points mentioned in lines 1 and 2 above were in conformance with regulations and rules therefore as required in the current manual of survey instructions of the United States Department of the Interior, Bureau of Land Management or by a decree of a Court of Law and/or that the corner points mentioned in lines 3, 4 and 5 above were in conformance with the rules of the Michigan Board of Land Surveyors or by a Decree of a Court of Law; established, re-established, monumented, re-monumented, recovered, found as expressed below:

NOTE: Not more than 4 corners, all in the same town and range, may be recorded on this certificate.

	A	B	C	D	E	F	G	H	I	J	K	L	M
2	6		5		4		3		2		1		
3													
4	7		3		9		10		11		12		
5													
6	16		17		16		15		14		13		
7													
8	19		20		21		22		23		24		
9													
10	30		29		28		27		26		25		
11													
12	31		32		33		34		35		36		
13													

A. Description of original monument and accessories and/or subsequent restoration:

1834 G.L.O. Notes
 Orange Risdon, D.S.
 Set post corner of
 Section 1 & 12
 Lynn 12N22W 19L
 Beech 10S2W 28L

Apr. 15, 1972 Survey by Robert G. Kay, R.L.S. #14096 recorded in Liber 1, Page 441, Tuscola County Records. N45°W 49.60' nail in t.p., N40°E 54.53' face t.p., N45°E 44.67' 1.25" sign post. May 21, 1971 Act 74 form filed* on Page 13, Denmark Twp. Fnd. 1/4" re-rod. N40°E 54.93' double headed nail & disk in guy pole, S65°W 60.02' double headed nail & disk in t.p., N55°E 44.8' rd. sign post, N45°W 49.51' nail & cap in t.p.

*by D.T.Rowe, LS #11192,

Section A continued on back of form.

B. Description of corner evidence found and/or method applied in restoring or reestablishing corner:

Found 1/2" x 18" re-rod in place, also found 1 1/4" x 36" pipe in center of rock pile at 18" below grade. Accepted 1/2" re-rod & pipe, as the proper position of Corner M-3.

C. Description of monument for corner and accessories established to perpetuate locating the position of the corner:


Removed 1/2" re-rod and 1 1/4" pipe and placed concrete monument with standard brass cap stamped Corner M-3, T12N-R7E. Placed monument box over mon.
 S48°23'W 26.10' set 1/2" x 18" re-rod in road shoulder.
 N45°30'W 49.51' set T.C. Remon. tag & spike above bottle cap & nail fnd. in SE face t. pole stub.
 N35°04'E 55.22' fnd. dbl. headed nail & 1 1/2" disk in NW face guy pole.
 S50°11'E 49.50' fnd. 1" pipe extending 3' above grade.

Signed by [Signature]

Date Nov. 14, 1995

Surveyor's Michigan License No. 23503

APPROVED
11-14-95
[Signatures]

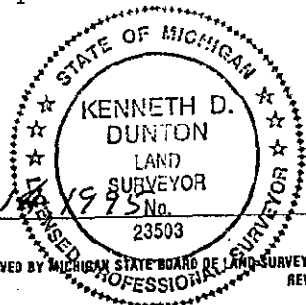

FORM APPROVED BY MICHIGAN STATE BOARD OF LAND SURVEYORS, JAN. 26, 1971
 REVISED MAY 14, 1976
 REVISED JAN., 1983

SURVEY &
 TELKOP
 DEC 01 1995
 COMMISSION

COPY

Section A continued:

May, 1971 Act 74 form filed by D. T. Rowe, R.L.S. #11192 on Page 21, Denmark Township. Found 1/2" re-rod. N55°E 44.8' road sign post, North 3' centerline pavement West., N45°W 49.51' nail & cap in t.p.
Nov. 1, 1973 Survey by D. T. Rowe, R.L.S. #11192, recorded in Liber 436 on Pages 257 & 258, Tuscola County, Records. 1/4" re-rod. N40°E 54.87' double headed nail & disk in guy pole, N40°W 49.51' nail & cap in t.p., S75°W 60.00' double headed nail & disk in guy pole.
Dec. 20, 1974 Survey by Arthur H. Leach, R.L.S. #7236, recorded in Liber 446 on Page 755, Tuscola County Records. Fnd. 1/4" re-rod. No accessories given.
Dec. 20, 1974 Act 74 form filed by A. H. Leach, R.L.S. #7236 on Page 28, Denmark Township. Fnd. 1/4" re-rod. Accessories same as Survey Liber 436, page 258.

