

1995 REMONUMENTATION PROGRAM
LAND CORNER RECORDATION CERTIFICATE
 Filing Requirement of Act 74, Mich. P.A. 1970

RECEIVED FOR RECORD
 LIBER NO. _____ PAGE NO. _____
 FILING NO. # 74
 DENMARK TWP
 95 NOV 21 PM 2:59
 VIRGINIA H. McLAUREN
 TUSCOLA COUNTY
 REGISTER OF DEEDS

For corners in Denmark Township

| | | |
|---|-------------------------|---------------|
| <u>Tuscola</u> <small>(County)</small> | Located In: | Corner Code # |
| 1. Public Land Survey | T 12N R 7E | M-4 |
| | T _____ R _____ | _____ |
| | T _____ R _____ | _____ |
| | T _____ R _____ | _____ |
| 2. Property Controlling in Section | S _____ T _____ R _____ | _____ |
| | S _____ T _____ R _____ | _____ |
| 3. Miscellaneous Property in Sec. | S _____ T _____ R _____ | _____ |
| | S _____ T _____ R _____ | _____ |

Register of Deeds Stamp & File Number

4. Lot No. _____, Recorded Plat _____
 5. Private Claims _____

| A | B | C | D | E | F | G | H | I | J | K | L | M |
|----|----|----|----|----|----|----|---|---|---|---|---|---|
| 2 | 6 | 5 | 4 | 3 | 2 | 1 | | | | | | |
| 3 | | | | | | | | | | | | |
| 4 | 7 | 8 | 9 | 10 | 11 | 12 | | | | | | |
| 5 | | | | | | | | | | | | |
| 6 | 18 | 17 | 16 | 15 | 14 | 13 | | | | | | |
| 7 | | | | | | | | | | | | |
| 8 | 19 | 20 | 21 | 22 | 23 | 24 | | | | | | |
| 9 | | | | | | | | | | | | |
| 10 | 30 | 29 | 28 | 27 | 26 | 25 | | | | | | |
| 11 | | | | | | | | | | | | |
| 12 | 31 | 32 | 33 | 34 | 35 | 36 | | | | | | |
| 13 | | | | | | | | | | | | |

I, Kenneth D. Dunton, in a field survey on October 21, 19 95, do hereby certify that under requirements of P.A. 74, Michigan P.A. of 1970, the corner points mentioned in lines 1 and 2 above were in conformance with regulations and rules therefore as required in the current manual of survey instructions of the United States Department of the Interior, Bureau of Land Management or by a decree of a Court of Law and/or that the corner points mentioned in lines 3, 4 and 5 above were in conformance with the rules of the Michigan Board of Land Surveyors or by a Decree of a Court of Law; established, re-established, monumented, re-monumented, recovered, found as expressed below:

NOTE: Not more than 4 corners, all in the same town and range, may be recorded on this certificate.

A. Description of original monument and accessories and/or subsequent restoration:

1834 G.L.O. Notes Orange Risdon, D.S. Set 1/4 Section Post W. maple 12 N69W 26L Elm 8 S48W 48L
 May 22, 1971 Survey by David T. Rowe; L.S. #11192 recorded in Liber 1, Page 47 Tuscola County Records. Set "T" iron N75°E 23.28' E. end of 43' x 72" CMP, N75°W 22.74' west end of CMP, North 8.5' center of CMP. August 16, 1973 Act 74 form filed by David T. Rowe, R.L.S. #11192 on Page 21, Denmark Township. N30°E 114.25' nail & cap in p.p., N25°W 138.40' nail & cap in t.p., West centerline of pavement. Measured mile 5273.44' & split (2636.72'). Set "T" iron on line.

Section A continued on back of this form.

B. Description of corner evidence found and/or method applied in restoring or reestablishing corner:


Found conc. nail at road surface, found bent "T" iron 0.3' North & 0.11' East of nail. Further investigation uncovered the remains of a 4" square wood post hacked to a point, surrounded by several rocks. Wood post located 0.04' South and 0.18' East of conc. nail found. Accepted wood post as the proper position of Corner M-4.

C. Description of monument for corner and accessories established to perpetuate locating the position of the corner:

Removed wood post and placed concrete monument with standard brass cap stamped Corner M-4, T12N-R7E.
 Placed monument box over monument.
 S39°42'W 24.35' set 1/2" x 18" re-rod in road shoulder.
 S37°52'E 23.98' set 1/2" x 18" re-rod in road shoulder.
 N67°07'W 22.97' chiseled notch atop W. end 43' of 72" C.S.P.
 N66°10'E 23.28' chiseled notch atop E. end 43' of 72" C.S.P.
 N30°35'E 114.62' set T. C. Remon. tag & spike over bottle cap & nail found in SW face of p. pole.

Signed by [Signature] Date Nov. 14, 1995

Surveyor's Michigan License No. 23503 **APPROVED**
11-14-95

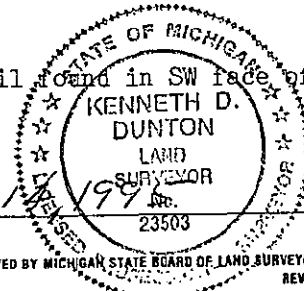

FORM APPROVED BY MICHIGAN STATE BOARD OF LAND SURVEYORS, JAN. 28, 1971
 REVISED MAY 14, 1975
 REVISED JAN., 1993

DEC 3 1995

COMMISSIONER

COPY

Section A continued :

August 6, 1974 Survey by David T. Rowe, R.L.S. #11192, recorded in Liber 445, Page 752 Tuscola County Records. N75°E 23.23' centerline 43' of 72" CMP. N75°W 22.74' centerline 43' of 72" C.M.P.
April 27, 1987 Survey by Jack N. Owens, L.S. #20709, recorded in Liber 571, Page 1355 Tuscola County Records. Found bent "T" iron, set masonry nail. N30°E 114.25' nail & cap in p.p., West C/L of pavement, North 8.5' C/L of ditch, N75°E 23.23' top of E. end of 43' of 72" C.M.P.

