

1995 REMONUMENTATION PROGRAM  
**LAND CORNER RECORDATION CERTIFICATE**  
 Filing Requirement of Act 74, Mich. P.A. 1970

For corners in Denmark Township  
Tuscola  
 (County)

Located In: Corner Code ##

1. Public Land Survey	T <u>12N</u> R <u>7E</u>	<u>M-5</u>
	T _____ R _____	_____
	T _____ R _____	_____
	T _____ R _____	_____
2. Property Controlling in Section	S _____ T _____ R _____	_____
	S _____ T _____ R _____	_____
3. Miscellaneous Property in Sec.	S _____ T _____ R _____	_____
	S _____ T _____ R _____	_____

RECEIVED FOR RECORD  
 LIBER NO. \_\_\_\_\_ PAGE NO. \_\_\_\_\_  
 FILING NO. # 75  
DENMARK TWP.  
 95 NOV 21 PM 2:59  
 VIRGINIA M. McLAREN  
 TUSCOLA COUNTY  
 REGISTER OF DEEDS

Register of Deeds Stamp & File Number

4. Lot No. \_\_\_\_\_, Recorded Plat \_\_\_\_\_  
 5. Private Claims \_\_\_\_\_

I, Kenneth D. Dunton, in a field survey on October 21, 19 95, do hereby certify that under requirements of P.A. 74, Michigan P.A. of 1970, the corner points mentioned in lines 1 and 2 above were in conformance with regulations and rules therefore as required in the current manual of survey instructions of the United States Department of the Interior, Bureau of Land Management or by a decree of a Court of Law and/or that the corner points mentioned in lines 3, 4 and 5 above were in conformance with the rules of the Michigan Board of Land Surveyors or by a Decree of a Court of Law; established, re-established, monumented, re-monumented, recovered, found as expressed below:

	A	B	C	D	E	F	G	H	I	J	K	L	M
2	6	5	4	3	2	1							
3													
4	7	8	9	10	11	12							
5													
6	18	17	16	15	14	13							
7													
8	19	20	21	22	23	24							
9													
10	30	29	28	27	26	25							
11													
12	31	32	33	34	35	30							
13													

NOTE: Not more than 4 corners, all in the same town and range, may be recorded on this certificate.

A. Description of original monument and accessories and/or subsequent restoration:

1834 G.L.O. Notes  
 Orange Risdon, D.S.  
 Set Post Corner of  
 Section 12 & 13  
 Sugar 2 S46W 41L  
 Beech 12 N19W 42L

1928 M.S.H.D. plans. Iron pin in wagon hub. Tel. pole N58°45'E 37.6', fence corner N41°00'W 43.1', tel. pole S56°15'W 40.6'.  
 May 22, 1971 Survey by David T. Rowe, L.S. #11192, recorded in Liber 1, Page 47 Tuscola County Records. Fnd 1" bolt in mon. box. S40°E 55.24' nail in p.p., S35°W 76.34' nail in l.p.  
 May 28, 1971 Survey by Richard L. Sides, L.S. #13042 recorded in Liber 1, Page 53 Tuscola County Records. No witnesses.

Section A continued on back of form. recorded in Liber 1, Page 205 Tuscola County Records. NW 58.9' utility pole, NE 55.1' utility pole, SW 57.0' sign post

B. Description of corner evidence found and/or method applied in restoring or reestablishing corner:

Found 1" boat spike in monument box. Accepted as the proper location of Corner M-5.


C. Description of monument for corner and accessories established to perpetuate locating the position of the corner:

Placed standard brass cap stamped Corner M-5, T12N-R7E over 1" spike and encased cap & spike in concrete in monument box.  
 S28°39'W 49.30' North cor. iron frame of catch basin.  
 S47°44'W 76.10' center 4" iron lamp post.  
 N55°02'W 63.35' top SE corner conc. base tele. ped.  
 N38°39'W 56.25' center 3" iron post in concrete.  
 S35°38'E 55.29' fnd. dbl. headed nail & M.S.H.D. tag in NE face p. pole.  
 Also, #11192 tag in NE face & nail & bottle cap in NW face.

Signed by [Signature] Date Nov. 14, 1995

Surveyor's Michigan License No. 23503

APPROVED  
11-14-95  
 [Signatures]

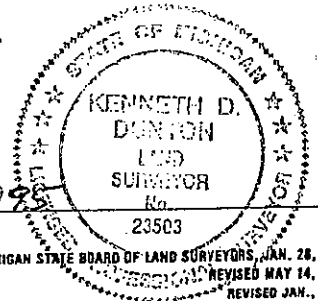

FORM APPROVED BY MICHIGAN STATE BOARD OF LAND SURVEYORS, JAN. 28, 1971  
 REVISED MAY 14, 1975  
 REVISED JAN., 1983

COPY

DEC 6 1995  
 COM

Section A continued:

Dec. 6, 1972 Act 74 form filed by David T. Rowe, R.L.S. #11192, filed on Page 13 Denmark Twp. Fnd. 1" bar. N35°W 58.35' nail & cap in t.p., S40°E 55.24' nail & cap in p.p., S35°W 76.34' nail & cap in l.p., S35°E 52' rd. sign post, South 14.1' centerline 24' asph. surface.  
 Oct. 2, 1972 Survey by Stephen Soltis, Jr., R.L.S. #19007, recorded in Liber 2, Page 72 Tuscola County Records. No mention of iron found or set or accessories.  
 Oct. 2, 1972 Act 74 form filed by Stephen Soltis, Jr., L.S. #19007 filed on Page 8 of Denmark Township, Northwest 58.9' utility pole, Northeast 55.1' utility pole, Southwest 57.0' sign post.  
 Aug. 16, 1973 Act 74 form filed by David T. Rowe, R.L.S. #11192, filed on Page 21, Denmark Township. Fnd 1" bar. N35°W 58.35' nail & cap in t.p., S40°E 55.24' nail & cap in p.p., S35°E 52' rd. sign post.  
 August 6, 1974 Survey by David T. Rowe, R.L.S. #11192 recorded in Liber 445, Page 752 Tuscola County Records. Fnd 1" bolt in mon. box. S35°W 76.34' nail in l.p., S40°E 55.24' nail in p.p., South 14.1' center line of 24' asph. surface.  
 June 10, 1976 Survey by Robert G. Kay, R.L.S. #14096 recorded in Liber 460, Page 597 Tuscola County Records. Found mon. box. S45°E 55.23' nail in p.p., S45°W 49.33' N. cor. C.B., N50°W 63.93' SE cor. concrete pad.

March 29, 1985 Survey by Lionel Roy Emery, L.S. #24593 recorded in Liber 544, Page 376 Tuscola County Records. Fnd. iron in mon. box. S40°E 55.24' N. & C. in pwr. pole, S35°E 52' road sign post, S35°W 76.34' N. & C. in l.p., N35°W 58.35' N. & C. in tele. pole.  
 April 27, 1987 Survey by Jack N. Owens, L.S. #20709, recorded in Liber 571 on Page 1355 Tuscola County Records. Found 1" bar in mon. box. S40°E 55.24' nail & cap in p.p., S35°W 76.34' nail & cap in l.p., S35°E 52' road sign post, South 14.1' C/L of pavement.  
 June 4, 1990 Survey by Kenneth D. Dunton, L.S. #23503 recorded in Liber 608, Pages 1137 & 1138, Tuscola County Records. No mention of object found or set or accessories.

