

1995 REMONUMENTATION PROGRAM
LAND CORNER RECORDATION CERTIFICATE
 Filing Requirement of Act 74, Mich. P.A. 1970

For corners in Denmark Township

<u>Tuscola</u> <small>(County)</small>	Located In:	Corner Code #:
1. Public Land Survey	T <u>12N</u> R <u>7E</u>	<u>M-7</u>
	T _____ R _____	_____
	T _____ R _____	_____
	T _____ R _____	_____
2. Property Controlling in Section	S _____ T _____ R _____	_____
	S _____ T _____ R _____	_____
3. Miscellaneous Property in Sec.	S _____ T _____ R _____	_____

RECEIVED FOR RECORD
 LIBER NO. _____ PAGE NO. _____
 FILING NO. #77
 DENMARK TWP
 95 NOV 21 PM 2:59
 VIRGINIA H. McLAUREN
 TUSCOLA COUNTY
 REGISTER OF DEEDS

Register of Deeds Stamp & File Number

4. Lot No. _____, Recorded Plat _____
 5. Private Claims _____

I, Kenneth D. Dunton, in a field survey on October 20, 19 95, do hereby certify that under requirements of P.A. 74, Michigan P.A. of 1970, the corner points mentioned in lines 1 and 2 above were in conformance with regulations and rules therefore as required in the current manual of survey instructions of the United States Department of the Interior, Bureau of Land Management or by a decree of a Court of Law and/or that the corner points mentioned in lines 3, 4 and 5 above were in conformance with the rules of the Michigan Board of Land Surveyors or by a Decree of a Court of Law; established, re-established, monumented, re-monumented, recovered, found as expressed below:

A	B	C	D	E	F	G	H	I	J	K	L	M
2	6	5	4	3	2	1						
3												
4	7	8	9	10	11	12						
5												
6	16	17	16	15	14	13						
7												
8	19	20	21	22	23	24						
9												
10	30	29	28	27	26	25						
11												
12	31	32	33	34	35	36						
13												

NOTE: Not more than 4 corners, all in the same town and range, may be recorded on this certificate.

A. Description of original monument and accessories and/or subsequent restoration:

1834 G.L.O. Notes
 Orange Risdon
 Set post corner of Section
 13 & 24
 Sugar 12 S58W 15L
 Hickory 9 N25W 31L

Aug. 30, 1971 Survey by Richard L. Sides, L.S. #13042 recorded in Liber 1 Page 205, Tuscola County Records. SW 56' utility pole, SE 108.30' 40" maple tree, E 29.75' sign post.
 Nov. 10, 1980 Survey by Kenneth D. Dunton, L.S. #23503, recorded in Liber 509, Page 1329, Tuscola County Records.
 Fnd. 5/8 rod. S 55°W 56.27' p.k. nail in p.p. S20°E 108.80' p.k. nail in 30" maple. East 3.0' centerline of pavement.
 Sept. 17, 1982 Act 74 form filed by Kenneth D. Dunton, L.S. #23503 on Page 43 Juniata Township. Same accessories as

B. Description of corner evidence found and/or method applied in restoring or reestablishing corner: Survey Liber 509, Page 1329.

Found 1/2" re-rod in place. Accepted as the proper position of Corner M-7.

C. Description of monument for corner and accessories established to perpetuate locating the position of the corner:


Removed 1/2" re-rod and placed concrete monument with standard brass cap stamped Corner M-7, T12N-R7E. Placed monument box over monument.
 S59°13'W 58.24' fnd. #11192 tag & spike in SE face p. pole.
 S16°56'E 108.73' set T. C. Remon. tag & spike above p.k. nail found in West face 42" maple.
 N37°52'W 39.88' set 1/2" x 18" re-rod in road shoulder.
 N47°25'E 26.62' set 1/2" x 18" re-rod in road shoulder.
 S57°28'E 24.24' set 1/2" x 18" re-rod in road shoulder.

Signed by [Signature] Date Nov. 14, 1995

Surveyor's Michigan License No. 23503

APPROVED

11-14-95

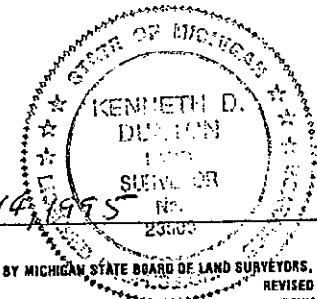

FORM APPROVED BY MICHIGAN STATE BOARD OF LAND SURVEYORS, JAN. 26, 1971
 REVISED MAY 14, 1975
 REVISED JAN., 1983

DEC 17 1995

COMMISSIONER

COPY

Section A continued:

Apr. 9, 1985 Survey by Lionel Roy Emery, L.S. #24593 recorded in Liber 549, Page 376 Tuscola County Records. Accessories same as Survey Liber 509 Page 1329.
June 24, 1988 Act 74 form filed by Paul A. Brown L.S. #33134, filed on Page 49 Juniata Township. Fnd. 5/8" rod. S50°W 50.50' C/L of galv. st. sign post, S55°W 58.27' set tag #11192 in ESE face of p.p., S20°E 108.78' fnd. p.k. & flag in W. face of 30" maple.

