

1995 REMONUMENTATION PROGRAM
LAND CORNER RECORDATION CERTIFICATE
 Filing Requirement of Act 74, Mich. P.A. 1970

For corners in Denmark Township

<u>Tuscola</u> (County)	Located In:	Corner Code =#
1. Public Land Survey	T <u>12N</u> R <u>7E</u>	<u>M-9</u>
	T _____ R _____	_____
	T _____ R _____	_____
	T _____ R _____	_____
2. Property Controlling in Section	S _____ T _____ R _____	_____
	S _____ T _____ R _____	_____
3. Miscellaneous Property in Sec.	S _____ T _____ R _____	_____
	S _____ T _____ R _____	_____

RECEIVED FOR RECORD
 LIBER NO. _____ PAGE NO. _____
 FILING NO. # 79
 DENMARK TWP.
 95 NOV 21 PM 3:00
 VIRGINIA H. McLANE
 TUSCOLA COUNTY
 REGISTER OF DEEDS

Register of Deeds Stamp & File Number

4. Lot No. _____, Recorded Plat _____
 5. Private Claims _____

A	B	C	D	E	F	G	H	I	J	K	L	M
2	6	5	4	3	2	1						
3												
4	7	8	9	10	11	12						
5												
6	18	17	16	15	14	13						
7												
8	19	20	21	22	23	24						
9												
10	30	29	28	27	26	25						
11												
12	31	32	33	34	35	36						
13												

I, Kenneth D. Dunton, in a field survey on October 15, 19 95, do hereby certify that under requirements of P.A. 74, Michigan P.A. of 1970, the corner points mentioned in lines 1 and 2 above were in conformance with regulations and rules therefore as required in the current manual of survey instructions of the United States Department of the Interior, Bureau of Land Management or by a decree of a Court of Law and/or that the corner points mentioned in lines 3, 4 and 5 above were in conformance with the rules of the Michigan Board of Land Surveyors or by a Decree of a Court of Law; established, re-established, monumented, re-monumented, recovered, found as expressed below:

NOTE: Not more than 4 corners, all in the same town and range, may be recorded on this certificate.

A. Description of original monument and accessories and/or subsequent restoration:

1834 G.L.O. Notes
 Orange Risdon, D.S.
 Set Post Corner of
 Section 24 & 25
 Beech 10 S55W 14L
 Beech 8 N68W 47L

June 18, 1974 Act 74 form filed by David T. Rowe, L.S. #11192 recorded on Page 4 Juniata Twp. Tuscola County Records. Fnd 1 1/2" pipe N60°E 43.40' face of road sign post, S35°E 50.80' R.L.S. #11192 tag in p.p., S50°W 63.25' R.L.S. #11192 tag in p.p.
 Apr. 18, 1975 Act 74 form filed by John W. Martin, L.S. #4699 recorded on Page 30 Denmark Township, Tuscola County Records. 2" pipe N.E. 36.15' to ctr. st. sign post. S.E. 50.85' to nail & cap in W. face p. pole. S.W. 63.25' to nail & cap in E. face p. pole.

Section A continued on back of form.

B. Description of corner evidence found and/or method applied in restoring or reestablishing corner:

Found 2" pipe in place. Accepted pipe as the proper position of Corner M-9.

C. Description of monument for corner and accessories established to perpetuate locating the position of the corner:


Removed 2" pipe & placed concrete monument with standard brass cap stamped Corner M-9, T12N-R7E. Placed monument box over monument.
 S52°10'W 63.25' fnd. #11192 tag & nail in NE face p. pole.
 S36°43'E 50.84' fnd. #11192 tag & nail in NW face p. pole.
 N43°05'W 31.75' set 1/2" x 18" re-rod in shoulder of road.
 N45°13'E 33.71' set 1/2" x 18" re-rod in shoulder of road.

Signed by *Kenneth D. Dunton*

Date Nov. 14, 1995

Surveyor's Michigan License No. 23503

APPROVED
11-14-95
J.M.E.

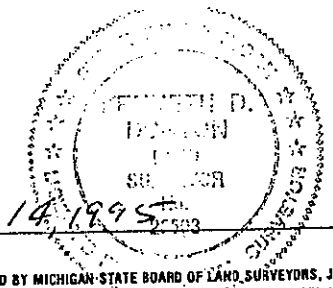

FORM APPROVED BY MICHIGAN STATE BOARD OF LAND SURVEYORS, JAN. 28, 1971
 REVISED MAY 14, 1975
 REVISED JAN., 1983

DEC 11 1995
 COMMISSION

COPY

Section A continued:

Sept. 6, 1980 Survey by Kenneth D. Dunton, R.L.S. #23503, recorded in Liber 509, Page 1329. Found 1 1/2" pipe. Same accessories as Act 74, Page 4, Juniata Township.

Oct. 29, 1981 Survey by Ronald C. Prevost L.S. #24612 recorded in Liber 520 Page 1414, Tuscola County Records. Same accessories as Act 74, Page 4, Juniata Township.

