

1995 REMONUMENTATION PROGRAM
LAND CORNER RECORDATION CERTIFICATE
 Filing Requirement of Act 74, Mich. P.A. 1970

For corners in Denmark Township

<u>Tuscola</u> <small>(County)</small>	Located In:	Corner Code #
1. Public Land Survey	T <u>12N</u> R <u>7E</u>	<u>M-12</u>
	T _____ R _____	_____
	T _____ R _____	_____
	T _____ R _____	_____
2. Property Controlling in Section	S _____ T _____ R _____	_____
	S _____ T _____ R _____	_____
3. Miscellaneous Property in Sec.	S _____ T _____ R _____	_____
	S _____ T _____ R _____	_____

RECEIVED FOR RECORD
 LIBER NO. _____ PAGE NO. _____
 FILING NO. # 83
Denmark Twp.
 95 NOV 21 PM 3:00
 VIRGINIA M. McLAUREN
 TUSCOLA COUNTY
 REGISTER OF DEEDS

Register of Deeds Stamp & File Number

4. Lot No. _____, Recorded Plat _____
 5. Private Claims _____

	A	B	C	D	E	F	G	H	I	J	K	L	M
2	6	5	4	3	2	1							
3													
4	7	8	9	10	11	12							
5													
6	16	17	16	15	14	13							
7													
8	19	20	21	22	23	24							
9													
10	30	29	28	27	26	25							
11													
12	31	32	33	34	36	36							
13													

I, Kenneth D. Dunton, in a field survey on October 15, 19 95, do hereby certify that under requirements of P.A. 74, Michigan P.A. of 1970, the corner points mentioned in lines 1 and 2 above were in conformance with regulations and rules therefore as required in the current manual of survey instructions of the United States Department of the Interior, Bureau of Land Management or by a decree of a Court of Law and/or that the corner points mentioned in lines 3, 4 and 5 above were in conformance with the rules of the Michigan Board of Land Surveyors or by a Decree of a Court of Law; established, re-established, monumented, re-monumented, recovered, found as expressed below:

NOTE: Not more than 4 corners, all in the same town and range, may be recorded on this certificate.

A. Description of original monument and accessories and/or subsequent restoration:

1834 G.L.O. Notes	Old T.C.R.C. plans Vassar Rd. - no date
Orange Risdon, D.S.	2" pipe. N70°W 14' power pole. East 45.25' power pole.
Set 1/4 Section Post	N50°E 51.7' brass tab in root of 12" maple.
Lynn 12 S12W 18L	M.S.H.D. plans 1956. Corner shown, no witnesses given.
Beech 18 N43W 28L	M.S.H.D. plans 1961. 3/4" iron pipe 5" deep. N85°W 26.74'
	24" basswood. N40°E 52.89' 25" maple, S18°E 58.08' 16" maple.
	Aug., 1972 Act 74 form filed by David T. Rowe, R.L.S. 11192,
	Page 15 of Denmark Twp. Fnd 1" pipe. N35°E 52.25' nail in 24"
	maple. S25°E 57.72' nail in 16" maple. N65°W 73.81' nail
	in p.p. East 45.46' nail in p.p.

Section A continued on back of form.

B. Description of corner evidence found and/or method applied in restoring or reestablishing corner:

Found 3/4" iron bar in monument box. Accepted iron bar in monument box as the proper position of Corner M-12.


C. Description of monument for corner and accessories established to perpetuate locating the position of the corner:

Set standard brass cap stamped corner M-12, T12N-R7E, over 3/4" iron bar. Encased brass cap & iron bar in concrete in monument box.
 S50°W 21.28' set 1/2" x 18" re-rod in road shoulder.
 N74°41'W 73.85' set T.C. Remon. tag & spike over #11192 tag & nail found in E. face p. pole.
 N88°16'E 45.49' set T.C. Remon. tag & spike over #11192 tag & nail found in W. face p. pole.
 N32°27'E 46.60' chiseled notch atop S. end 12" CSP drive culvert.

Signed by [Signature]
 Surveyor's Michigan License No. 23503

Date Nov. 14, 1995

APPROVED
11-14-95
 [Signature]

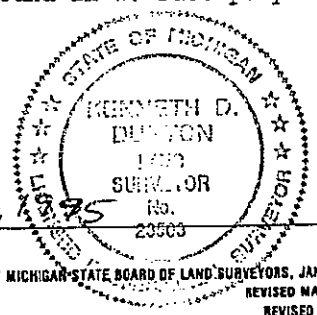

FORM APPROVED BY MICHIGAN STATE BOARD OF LAND SURVEYORS, JAN. 28, 1971
 REVISED MAY 14, 1975
 REVISED JAN., 1983

COPY

Section A continued:

Aug. 6, 1991 Survey by Earl E. Gravlin, L.S. #23510. Recorded in Liber 615 Page 695
Tuscola County Records. Fnd. 1" pipe. N65°W 74.20' p. pole. East 45.88' p. pole. N50°E 46.32'
end CMP.

