




Section A continued:

May, 1971 Act 74 form filed by D. T. Rowe, R.L.S. #11192 on Page 21, Denmark Township. Found 1/2" re-rod. N55°E 44.8' road sign post, North 3' centerline pavement West., N45°W 49.51' nail & cap in t.p.

Nov. 1, 1973 Survey by D. T. Rowe, R.L.S. #11192, recorded in Liber 436 on Pages 257 & 258, Tuscola County, Records. 1/4" re-rod. N40°E 54.87' double headed nail & disk in guy pole, N40°W 49.51' nail & cap in t.p., S75°W 60.00' double headed nail & disk in guy pole.

Dec. 20, 1974 Survey by Arthur H. Leach, R.L.S. #7236, recorded in Liber 446 on Page 755, Tuscola County Records. Fnd. 1/4" re-rod. No accessories given.

Dec. 20, 1974 Act 74 form filed by A. H. Leach, R.L.S. #7236 on Page 28, Denmark Township. Fnd. 1/4" re-rod. Accessories same as Survey Liber 436, Page 258.

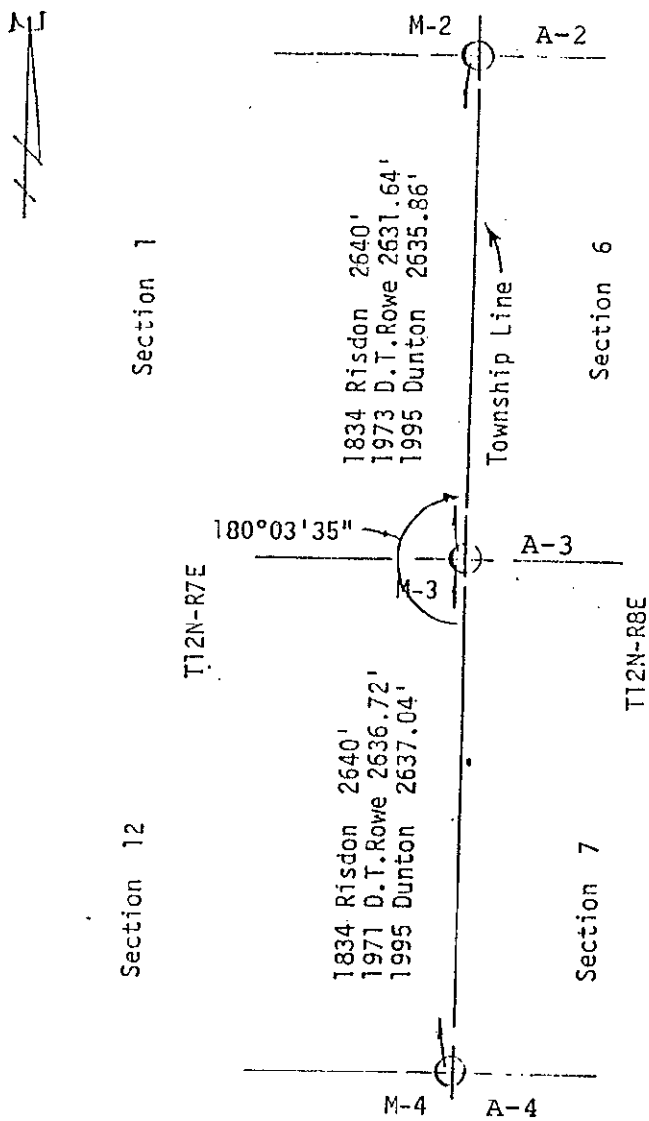

COPY