

SURVEY & REMONUMENTATION

MAY 05 1997

COMMISSION

1996 REMONUMENTATION PROGRAM
LAND CORNER RECORDATION CERTIFICATE
 Filing Requirement of Act 74, Mich. P.A. 1970

For corners in Juniata Township

TUSCOLA

(County)

Located in:

Corner Code #

- | | | |
|------------------------------------|-----------------|--------------|
| 1. Public Land Survey | T12N R8E | <u>A-8</u> ✓ |
| | T R | |
| | <u>T12N R7E</u> | <u>M-8</u> |
| | T R | |
| 2. Property Controlling in Section | S T R | |
| | S T R | |
| 3. Miscellaneous Property in Sec. | S T R | |
| | S T R | |

RECEIVED FOR RECORD
 LIBER NO. _____ PAGE NO. _____
 FILE NO. #93 Juniata
 96 OCT 31 AM 10:38
 TUSCOLA COUNTY REGISTERED DEEDS
 Register of Deeds Stamp & File Number

4. Lot No. _____, Recorded Plat _____

5. Private Claims _____

I, Kenneth D. Dunton, in a field survey on Oct. 20, 1995 do hereby state that under requirements of P.A. 74, Michigan P.A. of 1970, the corner points mentioned in lines 1 and 2 above were in conformance with regulations and rules therefore as required in the current manual of survey instructions of the United States Department of the Interior, Bureau of Land Management or by a decree of a Court of Law and for that the corner points mentioned in lines 3, 4 and 5 above were in conformance with the rules of the Michigan Board of Land Surveyors or by a Decree of a Court of Law; established, re-established, monumented, recovered, found as expressed below:

NOTE: Not more than 2 corners, all in the same town and range, may be recorded on this certificate.

A	B	C	D	E	F	G	H	I	J	K	L	M
1												
2	6	5	4	3	2	1						
3												
4	7	8	9	10	11	12						
5												
6	18	17	16	15	14	13						
7												
8	19	20	21	22	23	24						
9												
10	30	29	28	27	26	25						
11												
12	31	32	33	34	35	36						
13												

A. Description of original monument and accessories and/or subsequent restoration:

1834 G.L.O. Notes
 Orange Risdon, D.S.
 Set 1/4 Section Post
 Elm 18 S58W 22L
 W. Oak 20 N35W 30L
 Corner M-8, T12N-R7E

Sept. 6, 1980 Survey by Kenneth D. Dunton, L.S. #23503 recorded in Liber 509 Page 1329, Tuscola County Records. Set railroad spike w/cross by single proportion method. N15°W 78.38' p.k. nail in 24" maple, West 19.95' p.k. nail in 30" maple, S85°W 78.09' NE cor. house #2760, S88°E 5.0' fnd. tin can buried 18" below asph. pave., east 5.0' centerline of asph. pave.
 Sept. 17, 1980 Act 74 form filed by Kenneth D. Dunton, L.S. #23503 Page 43 Juniata Township. Same accessories as Survey Liber 509, Page 1329.

B. Description of corner evidence found and/or method applied in restoring or reestablishing corner:
 Found railroad spike with "+" chiseled atop. Accepted spike as the proper position of Corner A-8.

C. Description of monument for corner and accessories established to perpetuate locating the position of the corner:

Removed railroad spike and placed concrete monument with standard brass cap stamped corner M-8, T12N-R7E. Placed monument box over monument. Set 11-19-95. S77°57'W 78.03' NE corner conc. block footings house #2760. N86°06'W 20.40' fnd. #11192 tag & spike in N. face 30" maple. N26°17'W 43.62' fnd. #11192 tag & spike in E. face 24" maple. N14°08'W 78.52' fnd. #11192 tag & spike in E. face 26" maple. N45°56'E 30.30' set 1/2" x 18" re-rod in shoulder of road. East 5' physical centerline N-S pavement.

Note: This corner is common to M-8, T12N-R7E.

Signed by [Signature] Date _____
 Surveyor's Michigan License No. 23503



APPROVED
 10-23-96
 RLB
 [Signatures]

FORM APPROVED BY MICHIGAN STATE BOARD OF PROFESSIONAL SURVEYORS, JAN. 28, 1971
 REVISED MAY 14, 1975
 REVISED JAN., 1983
 REVISED OCT., 1985



CADV

26

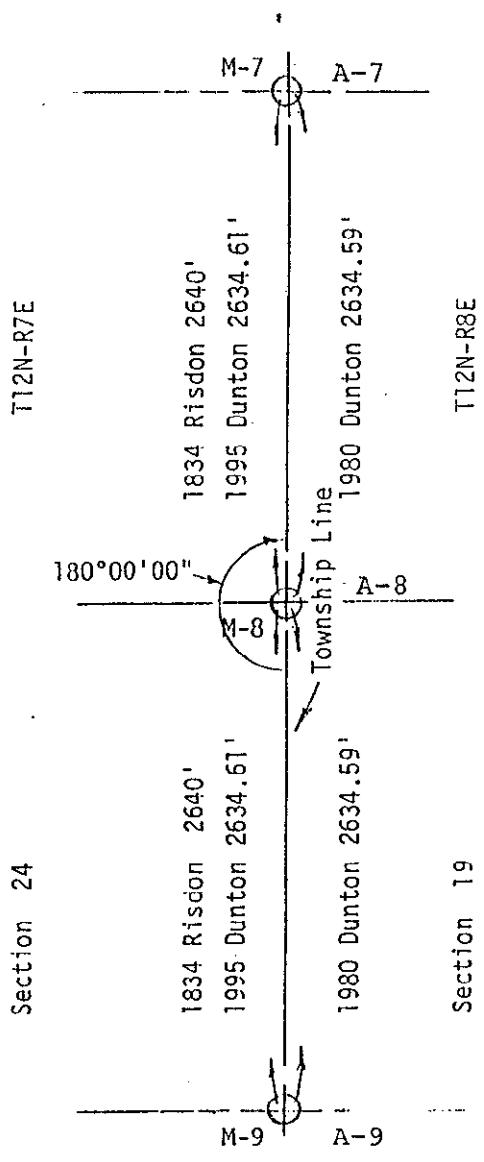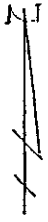

COPY