

LAND CORNER RECORDATION CERTIFICATE

Filing Requirement of Act 74, Mich. P.A. 1970
1995 REMONUMENTATION PROGRAM

For corners in JUNIATA TWP.
TUSCOLA
(County)

Located In:

Corner Code #

- | | | |
|---------------------------------------|-------------------------|-------|
| 1. Public Land Survey | T 12N R 08E | F-13 |
| | T _____ R _____ | _____ |
| | T _____ R _____ | _____ |
| | T _____ R _____ | _____ |
| 2. Property Controlling in Section | S _____ T _____ R _____ | _____ |
| | S _____ T _____ R _____ | _____ |
| 3. Miscellaneous Property in Sec. | S _____ T _____ R _____ | _____ |
| | S _____ T _____ R _____ | _____ |
| 4. Lot No. _____, Recorded Plat _____ | | |
| 5. Private Claims _____ | | |

RECEIVED FOR RECORD
LIBER NO. _____ PAGE NO. _____
FILING NO. # 72
Juniata Twp.
95 OCT 30 AM 9:35
VIRGINIA H. McLAUGHLIN
TUSCOLA COUNTY
REGISTER OF DEEDS

Register of Deeds Stamp & File Number

I, JONATHAN M. FIELD, in a field survey on SEPTEMBER 30 19 95
do hereby certify that under requirements of P.A. 74, Michigan P.A. of 1970, the corner points mentioned in lines 1 and 2 above were in conformance with regulations and rules therefore as required in the current manual of survey instructions of the United States Department of the Interior, Bureau of Land Management or by a decree of a Court of Law and/or that the corner points mentioned in lines 3, 4 and 5 above were in conformance with the rules of the Michigan Board of Land Surveyors or by a Decree of a Court of Law, established, re-established, monumented, re-monumented, recovered, found as expressed below:

NOTE: Not more than 4 corners, all in the same town and range, may be recorded on this certificate.

	A	B	C	D	E	F	G	H	I	J	K	L	M
1													
2	6	5	4	3	2	1							
3													
4	7	8	9	10	11	12							
5													
6	18	17	16	15	14	13							
7													
8	19	20	21	22	23	24							
9													
10	30	29	28	27	26	25							
11													
12	31	32	33	34	35	36							
13													

A. Description of original monument and accessories and/or subsequent restoration:

- 1821 GLO; WAMPLER, D.S.; SET POST; ASH 14 N10W 8LKS., SUGAR 9 S26E 20LKS.
- 1894 FELTON, C.S.; SURVEY OF SEC.33; CEDAR POST & 2 BRICKS SET FROM MEAS.; NO WITS GIVEN
- 1970 ROWE ENG.; NOTES FROM SURVEY JOB NO. C-0063-70; FND WOOD HUB SET T-IRON; NORTH 33' SET T
- 1975 ROWE, P.S.#11192; LCRC PG.18; FND ROTTED WOOD HUB SET T-IRON; NORTH 24.7' E-W FENCE LINE N10E 53.5' SPIKE IN 8" POPLAR, N40E 53.1' SPIKE IN 8" POPLAR
- 1977 URBAN ENG. CO.; WILKERSON, P.S.#21584; SURVEY L.474 PG. 209-10; FND WOOD HUB & T-IRON; SAME WITS AS 1975 LCRC ABOVE
- 1977 ROWE ENG.; DUNTON, P.S.#23503; SURVEY L.479 PG.809-10; T-IRON; N10E 53.5' SPIKE IN 8" POPLAR, N40E 53.1' SPIKE IN 8" POPLAR, S15W 33.4' SPIKE IN CLUMP OF 4-5" BIRCH TREES
- 1979 ROWE ENG.; QUIST, P.S.#25868; SURVEY L.499 PG.646; 1/2" IRON, T-IRON, WOOD STAKE; S30W 10.20' FND 1/2" PIPE, NORTH 33.00' T-IRON, S15W 33.50' TAG #11192 IN BIRCH CLUMP
- 1980 URBAN ENG. CO.; WILKERSON, P.S.#21584; SURVEY L.509 PG.1306-7; FND & USED IRON ROD; NORTH 33.0' T-IRON, S15W 33.52' CAP #11192 IN CLUMP BIRCH, N80W 101.20' NAIL IN MAILBOX POST


B. Description of corner evidence found and/or method applied in restoring or reestablishing corner:

- 1995 ROWE ENG.; FIELD, P.S.#37276; FND 1/2" ROD IN C/L GRAVEL ROAD E-W; RECOVERED 2 PREVIOUS WITS INDICATING THAT FND ROD IS IN SAME POSITION AS 1970 T-IRON CITED ABOVE

ACCEPTED FND 1/2" ROD AS BEST EVIDENCE OF ORIGINAL CORNER POSITION

C. Description of monument for corner and accessories established to perpetuate locating the position of the corner:

- F-13 REPLACED FND. 1/2" ROD W/ STANDARD REMON MONUMENT STAMPED CAP "F 13 T12N R8E"
- NORTH, 33.00' FND. T-IRON
- NORTH, 24.7' FALLEN E-W FENCE LINE
- S10°W, 33.81' FND. NAIL W/TAG #37276 IN E. FACE 5" BIRCH IN CLUMP
- N15°W, 38.80' FND. NAIL W/TAG #37276 IN W. FACE TWIN 10" POPLAR
- N75°W, 101.20' FND. P-K NAIL IN S. FACE MAILBOX POST
- S30°E, 46.85' FND. NAIL W/TAG #37276 IN W. FACE 6" BIRCH

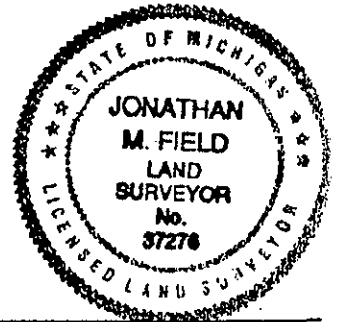

Signed by Jonathan M. Field
Surveyor's Michigan License No. 37276

Date 10-27-95

SURVEY &
RECORDATION

APPROVED
10-23-95

J.M.F.
J.M.G.

FORM APPROVED BY MICHIGAN STATE BOARD OF LAND SURVEYORS, JAN. 28, 1971
REVISED MAY 14, 1975
REVISED JAN., 1983
ADAPTED FOR WORD PROCESSING MARCH, 1983

DEC 1 1995

COMMISSION

COPY

