

LAND CORNER RECORDATION CERTIFICATE

Filing Requirement of Act 74, Mich. P.A. 1970.
1995 REMONUMENTATION PROGRAM

For corners in JUNIATA TWP.
TUSCOLA
(County)

Located In:

Corner Code #

1. Public Land Survey	T	12N	R	08E	J-13
	T		R		
	T		R		
	T		R		
2. Property Controlling in Section	S	T	R		
	S	T	R		
3. Miscellaneous Property in Sec.	S	T	R		
	S	T	R		

RECEIVED FOR RECORD
LIBER NO. _____ PAGE NO. _____
FILING NO. # 26
Juniata Twp
95 OCT 30 AM 9:35
VIRGINIA M. McLAUREN
TUSCOLA COUNTY
REGISTER OF DEEDS

Register of Deeds Stamp & File Number

4. Lot No. _____ Recorded Plat _____
5. Private Claims _____

I, JONATHAN M. FIELD, in a field survey on SEPTEMBER 30 19 95, do hereby certify that under requirements of P.A. 74, Michigan P.A. of 1970, the corner points mentioned in lines 1 and 2 above were in conformance with regulations and rules therefore as required in the current manual of survey instructions of the United States Department of the Interior, Bureau of Land Management or by a decree of a Court of Law and/or that the corner points mentioned in lines 3, 4 and 5 above were in conformance with the rules of the Michigan Board of Land Surveyors or by a Decree of a Court of Law; established, re-established, monumented, re-monumented, recovered, found as expressed below:

NOTE: Not more than 4 corners, all in the same town and range, may be recorded on this certificate.


	A	B	C	D	E	F	G	H	I	J	K	L	M
1													
2	6	5	4	3	2	1							
3													
4	7	8	9	10	11	12							
5													
6	18	17	16	15	14	13							
7													
8	19	20	21	22	23	24							
9													
10	30	29	28	27	26	25							
11													
12	31	32	33	34	35	36							
13													

A. Description of original monument and accessories and/or subsequent restoration:
1821 GLO; WAMPLER, D.S.; SET POST; HEMLOCK 36 N80E 21LKS., HEMLOCK 10 N81W 21LKS.
1895 TESKEY, C.S.; SURVEY OF SEC.35; STAKE & CROCK. AT EQUAL DIST. BETWEEN SECTION CORNERS
1983 ROWE ENG.; BOLDT, P.S.#28405; SURVEY L.540 PG.34-5; FND 1" POINTED IRON; N40E 50.27' TAG
IN POST W/RISER, S45E 18.46' TAG IN NW COR RR TIE, S15W 32.34' NAIL IN 5" POPLAR
1983 BOLDT, P.S.#28405; LCRC PG.46; FND 1" POINTED IRON; SAME WITS AS 1983 SURVEY ABOVE

B. Description of corner evidence found and/or method applied in restoring or reestablishing corner:
1995 ROWE ENG.; FIELD, P.S.#37276; FND 1" SQUARE ROD W/POINTED TOP 1'E OF C/L GRAVEL ROAD
N-E-W; RECOVERED 1 PREV. WIT INDICATING THAT FND ROD IS IN SAME POSITION AS 1983 ROD
CITED ABOVE

ACCEPTED FND ROD AS BEST EVIDENCE OF ORIGINAL CORNER POSITION

C. Description of monument for corner and accessories established to perpetuate locating the position of the corner:
J-13 REPLACED FND ROD W/ STANDARD REMON MONUMENT STAMPED CAP "J 13 T12N R8E"
N40°E, 50.27' FND. NAIL W/TAG #11192 IN S. FACE CUT-OFF T.POLE
S60°W, 66.97' NAIL W/TAG #37276 IN SE FACE 8" WHITE BIRCH
N45°W, 45.41' NAIL W/TAG #37276 IN NE FACE FENCE CORNER POST
S05°W, 37.96' NAIL W/TAG #37276 IN E. FACE 6" POPLAR

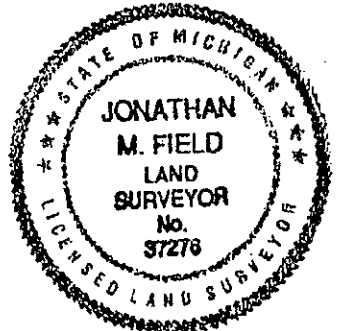

Signed by Jonathan M. Field Date 10-27-95
Surveyor's Michigan License No. 37276


APPROVED
10-16-95

FORM APPROVED BY MICHIGAN STATE BOARD OF LAND SURVEYORS, JAN. 26, 1971
REVISED MAY 14, 1976
REVISED JAN. 1983
ADAPTED FOR WORD PROCESSING MARCH, 1983

SURVEY &
REMONUMENTATION

DEC 6, 1995
COMMISSION

COPY

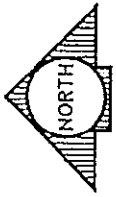

SE 1/4
SEC 35
T12N-R8E

SW 1/4
SEC 35
T12N-R8E

