

**SURVEY & REMONUMENTATION**

DEC 0 2 1993

**COMMISSION**

1993 REMONUMENTATION PROGRAM

**LAND CORNER RECORDATION CERTIFICATE**

Filing Requirement of Act 74, Mich. P.A. 1970

JUNIATA TOWNSHIP

For corners in

TUSCOLA  
County

Located In:

Corner Code =#

- |                                    |   |            |   |           |            |
|------------------------------------|---|------------|---|-----------|------------|
| 1. Public Land Survey              | T | <u>12N</u> | R | <u>8E</u> | <u>M-8</u> |
|                                    | T | _____      | R | _____     | _____      |
|                                    | T | _____      | R | _____     | _____      |
|                                    | T | _____      | R | _____     | _____      |
| 2. Property Controlling in Section | S | _____      | T | _____     | _____      |
|                                    | S | _____      | T | _____     | _____      |
| 3. Miscellaneous Property in Sec.  | S | _____      | T | _____     | _____      |
|                                    | S | _____      | T | _____     | _____      |

4. Lot No. \_\_\_\_\_, Recorded Plat \_\_\_\_\_
5. Private Claims \_\_\_\_\_

RECEIVED FOR RECORD  
LIBER NO. \_\_\_\_\_ PAGE NO. \_\_\_\_\_  
FILING NO. # 60  
93 OCT 22 PM 2:44  
JUN 11 1993  
VIRGINIA H. RYLANDER  
TUSCOLA COUNTY  
REGISTER OF DEEDS

Register of Deeds Stamp & File Number

I, Kenneth D. Dunton, in a field survey on June 13, 19 93, do hereby certify that under requirements of P.A. 74, Michigan P.A. of 1970, the corner points mentioned in lines 1 and 2 above were in conformance with regulations and rules therefore as required in the current manual of survey instructions of the United States Department of the Interior, Bureau of Land Management or by a decree of a Court of Law and/or that the corner points mentioned in lines 3, 4 and 5 above were in conformance with the rules of the Michigan Board of Land Surveyors or by a Decree of a Court of Law; established, re-established, monumented, re-monumented, recovered, found as expressed below:

**NOTE: Not more than 4 corners, all in the same town and range, may be recorded on this certificate.**

A. Description of original monument and accessories and/or subsequent restoration:

1821 G.L.O. Notes  
Joseph Wampler, D.S.  
Set 1/2 mile post  
Beech 18" S4°E 18.48'  
Hemlock 40" N20°W 7.26'

May 24, 1972 Survey Liber 1, Pages 540 & 541  
by David T. Rowe, R.L.S. #11192. Shows corner M-8. Does not indicate object found or set and gives no accessories. Drawing indicates "T" iron set S88°42'36"W 33.00'.

Note: Section A. continued on back of form.

B. Description of corner evidence found and/or method applied in restoring or reestablishing corner:

Found and accepted 1/2" re-rod. Dug 5' x 5' x 18" hole at split of mile at location per single proportion between M-7 and M-9. Found no other evidence.

C. Description of monument for corner and accessories established to perpetuate locating the position of the corner:

Removed 1/2" re-rod and set standard monument stamped M-8, T12N-R8E.  
N88°35'26"W 33.00' found "T" iron.  
N87°02'W 32.81' placed T.C. Re-mon. tag & spike over #11192 tag & spike in E. face of p.p.  
N25°10'E 79.78' found rod & cap #23503.  
S00°57'00"W 263.61' found 1/2" re-rod @ apparent cor. A-10, T12N-R9E.

	A	B	C	D	E	F	G	H	I	J	K	L	M
2	6		5		4		3		2		1		
3													
4	7		8		9		10		11		12		
5													
6	18		17		16		15		14		13		
7													
8	19		20		21		22		23		24		
9													
10	30		29		28		27		26		25		
11													
12	31		32		33		34		35		36		
13													

COPY

Signed by [Signature]


Date October 11, 1993

Surveyor's Michigan License No. \_\_\_\_\_

APPROVED  
10-11-93

[Signature]

FORM APPROVED BY MICHIGAN STATE BOARD OF LAND SURVEYORS, JAN. 20, 1970, REVISED MAY 14, 1979, REVISED JAN. 1993

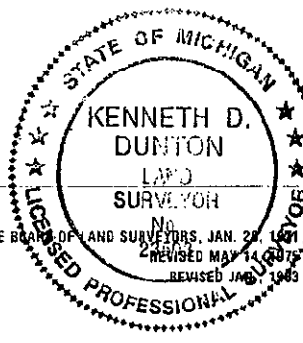

Continued from Section A. on reverse side of form:

August 10, 1973 Survey Liber 435, Pages 717 & 718 by David T. Rowe, R.L.S. #11192.  
Found re-rod.

N45°W 36.5' center of 12" pine.  
West 32.81' R.L.S. #11192 tag in t.p.  
South 263.71' pipe at W 1/4 cor., Sec. 30, T12N-R9E.

September 4, 1975 Survey Liber 453, Pages 488 & 489 by James Beck, R.L.S. #21559  
with Rowe Engineering. Re-rod.

West 32.81' R.L.S. #11192 tag in t.p.  
N45°W 36.5' center 12" pine.  
N25°W 55.9' center 8" pine.  
South 263.71' pipe at W 1/4 cor., Sec. 30, T12N-R9E.  
West 33.00' "T" iron.

Dec. 4, 1980 Survey Liber 511, Page 875 by Jan Fokens, R.L.S. #21567, with Rowe Engineering.  
Re-rod.

Accessories same as on Survey Liber 453, Pages 488 & 489 shown above.

October 27, 1981 Survey Liber 536, Pages 1133, 1134 & 1135 by Jan Fokens, R.L.S. #21567,  
with Rowe Engineering.

Found 1/2" re-rod.  
West 32.81' Rowe R.L.S. tag in t.p.  
N45°W 36.5' center of 12" pine stump.  
N25°W 55.9' center of 8" pine.

April 18, 1985 Survey Liber 578, Page 019 by Kenneth D. Dunton, R.L.S. #23503. Found  
1/2" re-rod.

West 32.81' tag in t.p.  
N45°W 36.5' center 12" pine stump.  
N25°W 55.9' to 10" pine.

