

**SURVEY & REMONUMENTATION**

DEC 0 2 1993

**COMMISSION**

1993 REMONUMENTATION PROGRAM  
**LAND CORNER RECORDATION CERTIFICATE**  
 Filing Requirement of Act 74, Mich. P.A. 1970  
 JUNIATA TOWNSHIP

For corners in

TUSCOLA  
 (County)

Located In:

Corner Code M-9

- 1. Public Land Survey T 12N R 8E M-9
- T \_\_\_\_\_ R \_\_\_\_\_
- T \_\_\_\_\_ R \_\_\_\_\_
- T \_\_\_\_\_ R \_\_\_\_\_
- 2. Property Controlling S \_\_\_\_\_ T \_\_\_\_\_ R \_\_\_\_\_
- in Section S \_\_\_\_\_ T \_\_\_\_\_ R \_\_\_\_\_
- 3. Miscellaneous S \_\_\_\_\_ T \_\_\_\_\_ R \_\_\_\_\_
- Property in Sec. S \_\_\_\_\_ T \_\_\_\_\_ R \_\_\_\_\_
- 4. Lot No. \_\_\_\_\_, Recorded Plat \_\_\_\_\_
- 5. Private Claims \_\_\_\_\_

RECEIVED FOR RECORD  
 LIBER NO. \_\_\_\_\_ PAGE NO. \_\_\_\_\_  
 FILING NO. 759  
 JUNIATA TOWNSHIP  
 93 OCT 22 PM 2:44  
 VIRGINIA H. JOHNSON  
 TUSCOLA COUNTY  
 REGISTER OF DEEDS

Register of Deeds Stamp & File Number

	A	B	C	D	E	F	G	H	I	J	K	L	M
2	6	5	4	3	2	1							
3													
4	7	8	9	10	11	12							
5													
6	18	17	16	15	14	13							
7													
8	19	20	21	22	23	24							
9													
10	30	29	28	27	26	25							
11													
12	31	32	33	34	35	36							
13													

I, Kenneth D. Dunton in a field survey on June 13, 19 93, do hereby certify that under requirements of P.A. 74, Michigan P.A. of 1970, the corner points mentioned in lines 1 and 2 above were in conformance with regulations and rules therefore as required in the current manual of survey instructions of the United States Department of the Interior, Bureau of Land Management or by a decree of a Court of Law and/or that the corner points mentioned in lines 3, 4 and 5 above were in conformance with the rules of the Michigan Board of Land Surveyors or by a Decree of a Court of Law; established, re-established, monumented, re-monumented, recovered, found as expressed below:

**NOTE: Not more than 4 corners, all in the same town and range, may be recorded on this certificate.**

A. Description of original monument and accessories and/or subsequent restoration:

1821 G.L.O. Notes  
 Joseph Wampler, D. S.  
 Set post cor. Sec. 24 & 25  
 Hemlock 7" S42°W 9.90'  
 Hemlock 34" N34°W 14.52'

Feb. 13, 1892  
 G. B. Felton, County Surveyor  
 Survey of Sec. 30, T12N-R9E,  
 under remarks states: SE cor.  
 Sec. 24, T12N-R8E cedar post  
 and crockery corner. (no  
 accessories given)

Aug. 26, 1895  
 Edward Teskey, County  
 Surveyor. Measured  
 from corner M-13 to M-9  
 (10,467.6') and set corner  
 M-11 5233.8' north of M-1.  
 No mention of evidence  
 found or accessories  
 at corner M-9.

Note: Section A. continued on back of form.

B. Description of corner evidence found and/or method applied in restoring or reestablishing corner:

Found 1/2" re-rod from accessories on reverse side of this form. Also found 4" diameter State of Michigan brass plate atop 4" iron casing, 32" below grade. 1/2" re-rod bears N50°26'20"W 1.02' from State of Michigan brass plate.

C. Description of monument for corner and accessories established to perpetuate locating the position of the corner:


Set 24" long standard monument <sup>with 2" brass cap stamped corner M-9, T12N-R8E</sup> atop State of Mich. brass plate.  
 N86°41'E 49.07' set T.C. Re-mon. tag & spike over p.k. nail in S. face 12" maple.  
 S29°16'E 28.69' found spike & tag #20709 in W. face 26" cottonwood.  
 S56°19'W 32.98' found spike & tag #20709 in E. face 15" tree.  
 N89°23'W 48.28' set T.C. Re-mon. tag & spike over p.k. nail in S. face 15" maple.  
 N56°00'W 30.64' found spike & tag #20709 in E. face 18" pin cherry.  
 N50°23'20"W 1.02' found 1/2" re-rod previously used as corner M-9.  
 S01°18'30"W 282.18' found 1/2" re-rod at apparent corner A-11, T12N-R9E.

Signed by [Signature]  
 Surveyor's Michigan License No. #23503

Date October 11, 1993

**APPROVED**  
10-11-93  
[Signature]

**COPY**

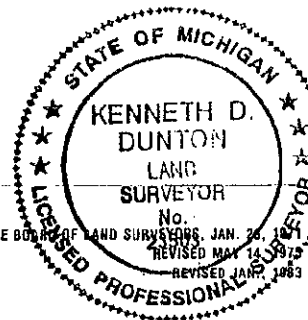

Continued from Section A. on front of this form:

August 10, 1973 Survey Liber 435, Pages 717 & 718 by David T. Rowe, R.L.S. #11192.

Set 1/2" re-rod with cap.

West 47.48' R.L.S. #11192 tag in 8" maple tree.

N45°W 41.92' R.L.S. #11192 tag in t. p.

N60°W 30.43' R.L.S. #11192 tag in 15" berry tree.

Sept. 4, 1975 Survey Liber 453, Pages 488 & 489 by James Beck, R.L.S. #21559 with Rowe Engineering. Re-rod w/cap

N45°W 41.92' R.L.S. #11192 tag in t. p.

West 47.48' R.L.S. #11192 tag in 8" maple.

South 282.48' USGS Mon. @ SW cor., Sec. 30, 12-9

Note: See Survey Liber 561, Page 611 for proper identification of monument found.

Sept. 27, 1981 Survey Liber 536, Pages 1333, 1334 & 1335 by Jan S. Fokens, R.L.S. #21567 with Rowe Engineering.

Found re-rod with cap.

Accessories same as Survey Liber 453, Pages 488 & 489 shown above.

April 18, 1985 Survey Liber 578, Page 019 by Kenneth D. Dunton, R.L.S. #23503.

Found 1/2" rod & cap.

Accessories same as Survey Liber 453, Pages 488 & 489 & Liber 536, Pages 1333, 1334 & 1335 shown above.

COPY

