

**SURVEY & REMONUMENTATION**

DEC 0 2 1993

**COMMISSION**

**1993 REMONUMENTATION PROGRAM  
LAND CORNER RECORDATION CERTIFICATE  
Filing Requirement of Act 74, Mich. P.A. 1970  
JUNIATA TOWNSHIP**

For corners in

TUSCOLA  
(County)

Located In:

Corner Code ##

- |                                       |                          |             |
|---------------------------------------|--------------------------|-------------|
| 1. Public Land Survey                 | T <u>12N</u> R <u>8E</u> | <u>M-11</u> |
|                                       | T _____ R _____          | _____       |
|                                       | T _____ R _____          | _____       |
|                                       | T _____ R _____          | _____       |
| 2. Property Controlling in Section    | S _____ T _____ R _____  | _____       |
|                                       | S _____ T _____ R _____  | _____       |
| 3. Miscellaneous Property in Sec.     | S _____ T _____ R _____  | _____       |
|                                       | S _____ T _____ R _____  | _____       |
| 4. Lot No. _____, Recorded Plat _____ |                          |             |
| 5. Private Claims _____               |                          |             |

RECEIVED FOR RECORD  
LIBER NO. \_\_\_\_\_ PAGE NO. \_\_\_\_\_  
FILING NO. JUNIATA 7012  
# 57  
93 OCT 22 PM 2:44  
VIRGINIA H. JENSEN  
TUSCOLA COUNTY  
REGISTER OF DEEDS

Register of Deeds Stamp & File Number

I, Kenneth D. Dunton, in a field survey on June 12, 19 93, do hereby certify that under requirements of P.A. 74, Michigan P.A. of 1970, the corner points mentioned in lines 1 and 2 above were in conformance with regulations and rules therefore as required in the current manual of survey instructions of the United States Department of the Interior, Bureau of Land Management or by a decree of a Court of Law and/or that the corner points mentioned in lines 3, 4 and 5 above were in conformance with the rules of the Michigan Board of Land Surveyors or by a Decree of a Court of Law; established, re-established, monumented, re-monumented, recovered, found as expressed below:

**NOTE: Not more than 4 corners, all in the same town and range, may be recorded on this certificate.**

A. Description of original monument and accessories and/or subsequent restoration:

1821 G.L.O. Notes  
Joseph Wampler, D.S.  
Set post cor. Sections 25 & 36  
Birch 16" N54°E 1.32'  
Birch 7" S15 1/2°W 12.54'

1834 G.L.O. Notes  
Harvey Parke, D.S.  
Chained West on South boundary of Sec. 31, T12N-R9E and intersected range line 361.68' South of cor. Sections 25 & 36, T12N-R8E.

Aug. 26, 1895  
Edward Teskey, County Surveyor  
Set from measure, stone & crockery at corner. N54°E 1.32' notch in birch and roof of stump. Set at 5233.8' N. of SE cor. 36 (now meas. 5233.22').

Note: Section A. continued on back of form.

B. Description of corner evidence found and/or method applied in restoring or reestablishing corner:

Found and accepted "T" iron. Found lag bolt with 1" square head below "T" iron. Found no other evidence.

C. Description of monument for corner and accessories established to perpetuate locating the position of the corner:

Set standard monument with 2" brass cap stamped corner M-11, T12N-R8E.  
N81°43'W 91.50' Set T.C. Re-mon. tag & spike over 11192 tag in E. face p.p.  
N39°46'W 56.10' set T.C. Re-mon. tag & spike over 11192 tag in fence post, SE face.  
N26°37'W 87.00' found tag #37276 & spike in east face of twin 12" maples.  
N85°30'E 146.65' set T.C. Re-mon. tag in N. face of p. pole.  
S52°00'E 41.68' found 1/2" rod and cap #11192.  
S37°22'E 135.65' NW corner footings of house.  
S00°00'30"E 361.62' found p. k. nail at apparent cor. A-13, T12N-R9E.


A	B	C	D	E	F	G	H	I	J	K	L	M
2	6	5	4	3	2	1						
3												
4	7	8	9	10	11	12						
5												
6	18	17	16	15	14	13						
7												
8	19	20	21	22	23	24						
9												
10	30	29	28	27	26	25						
11												
12	31	32	33	34	35	36						
13												

Signed by

*[Signature]*

Date October 4, 1993

Surveyor's Michigan License No. 23503

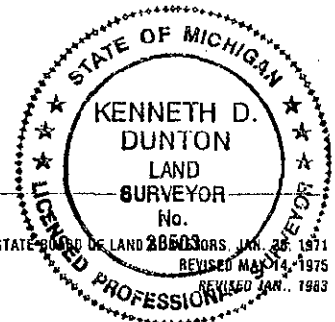

**APPROVED**  
10-4-93

Continued from Section A. on front of this form:

April 4, 1974 Act 74, Juniata Township, 12-8 Page 20 by David T. Rowe, R.L.S. #11192.

Found tag bolt with 1" sq. head 12" deep. Raised with "T" iron.

N85°W 91.51' R.L.S. tag 11192 in p. p.

N60°W 101.95' R.L.S. tag 11192 in maple.

North 12.0' centerline o. h. power line E & W.

South 316.68' p. k. nail at NW cor., Sec. 6, T11N-R9E.

June 27, 1974 - Revised July, 1975 Survey Liber 451, Pages 160, 161 & 162 by David T. Rowe, R.L.S. #11192. No statement of object found or set. Location sketch shows measurement of NE 1/4 of Section 36, T12N-R8E with distance of 2616.05' to corner M-12.

April 1, 1975 Survey Liber 452, Pages 646, 647 & 648 by James Beck, R.L.S. #21599. NE cor. 36, "T" iron.

N45°W 56.14' R.L.S. 11192 tag in fence post.

N80°W 91.46' R.L.S. 11192 tag in p. pole.

S50°E 135.61' NW cor. foundation of house.

July 21, 1975 Survey Liber 452, Pages 637, 638 & 639 by James Beck, R.L.S. #21559. NE cor. 36, "T" iron. Accessories same as Survey Liber 452, Pages 646, 647 & 648 above.

Feb. 17, 1976 Survey Liber 458, Pages 206 & 207 by James Beck, R.L.S. #21559. NE cor. 36, "T" iron. Accessories same as Survey Liber 452, Pages 637, 638, 639, 646, 647 & 648 above.

March 15, 1976 Survey Liber 461, Page 175 by James Beck, R.L.S. #21559. NE cor. 36, "T" iron. Accessories same as surveys by Beck as above.

