

SURVEY & REMONUMENTATION

DEC 02 1993

COMMISSION

**1993 REMONUMENTATION PROGRAM
LAND CORNER RECORDATION CERTIFICATE
Filing Requirement of Act 74, Mich. P.A. 1970**

RECEIVED FOR RECORD
LIBER NO. _____ PAGE NO. _____
FILING NO. # 55
JUNIATA TWP.
93 OCT 22 PM 2:43
VIRGINIA H. McLENNAN
TUSCOLA COUNTY
REGISTER OF DEEDS

For corners in TUSCOLA (County) Located In: JUNIATA TOWNSHIP Corner Code # 44

- 1. Public Land Survey T 12N R 8E M-13
T _____ R _____
T _____ R _____
T _____ R _____
- 2. Property Controlling S _____ T _____ R _____
in Section S _____ T _____ R _____
- 3. Miscellaneous S _____ T _____ R _____
Property in Sec. S _____ T _____ R _____
- 4. Lot No. _____, Recorded Plat _____
- 5. Private Claims _____

Register of Deeds Stamp & File Number

	A	B	C	D	E	F	G	H	I	J	K	L	M
2	6	5	4	3	2	1							
3													
4	7	8	9	10	11	12							
5													
6	13	17	16	15	14	13							
7													
8	19	20	21	22	23	24							
9													
10	30	29	28	27	26	25							
11													
12	31	32	33	34	35	36							

I, Kenneth D. Dunton, in a field survey on June 12, 1993, do hereby certify that under requirements of P.A. 74, Michigan P.A. of 1970, the corner points mentioned in lines 1 and 2 above were in conformance with regulations and rules therefore as required in the current manual of survey instructions of the United States Department of the Interior, Bureau of Land Management or by a decree of a Court of Law and/or that the corner points mentioned in lines 3, 4 and 5 above were in conformance with the rules of the Michigan Board of Land Surveyors or by a Decree of a Court of Law; established, re-established, monumented, re-monumented, recovered, found as expressed below:

NOTE: Not more than 4 corners, all in the same town and range, may be recorded on this certificate.

A. Description of original monument and accessories and/or subsequent restoration:

1821 G.L.O. Notes
Joseph Wampler, D.S.
Set post cor. Town 11 & 12
Hemlock 7" S?°E 10.56'
Hemlock 32" N73°W 9.90'

*Feb. 13, 1892
(see reverse side)

Aug. 26, 1895
Edward Teskey,
County Surveyor
Gas pipe at corner
No accessories given

March 15, 1976
Survey Liber 461, page 175
by James A. Beck, R.L.S. #21559
No statement of object found or s
No accessories given.

Note: Section A. continued on back of form.

B. Description of corner evidence found and/or method applied in restoring or reestablishing corner:


Found & accepted 5/8" Iron rod 30" long.

C. Description of monument for corner and accessories established to perpetuate locating the position of the corner:

Set standard monument with 2" brass cap stamped corner M-13, T12N-R8E & M-1, T11N-R8E.
S89°24'E 33.00' set 1/2" x 18" rod & cap #23503.
S00°49'40"E 373.41' found 1/2" rod at apparent cor. A-3, T11N-R9E.
S45°12'W 46.74' found 1/2" rod & cap #24588.
S52°25'W 66.90' set T. C. Re-mon. tag & spike in NW face power pole.

COPY

Signed by Kenneth D. Dunton Date October 4, 1993
Surveyor's Michigan License No. 23503

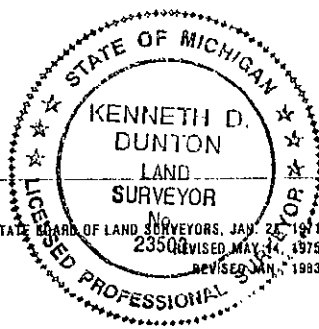

APPROVED
10-4-93
J.M.F.
1100
11/1/93

Continued from Section A. on front of this form:

July 8, 1977 Act 74, Vassar Twp. 11-8, Page 41 corner M-1 by Kenneth D. Dunton, R.L.S. #23503. Found 5/8" iron rod also found by Rowe Engineering in 4-5-74.

S35°E 51.56' R.L.S. 11192 tag in p.p.
South 42.2' centerline o.h. power line E & W.
N85°E 21.30' road sign post.
South 373.50' to SW cor., Sec. 6, T11N-R9E.

October 20, 1981 Survey Liber 520, Page 986 by Kenneth D. Dunton, R.L.S. #23503. Found 5/8" rod.

S50°W 35.0' stop sign post.
S35°E 51.6' tag in p. p.
South 42.0' centerline o.h. power line.

October 20, 1981 Act 74, Juniata Township, 12-8 page 43 by Kenneth D. Dunton, R.L.S. #23503 Found 5/8" rod. Accessories same as on Survey Liber 520, Page 986 shown above.

December 22, 1983 Act 74, Vassar Township, 11-8 page 67 by Lionel Emery, R.L.S. #24593. Shows corner M-1 (no mention of object found) and statement that M-1 was used for direction control of portion of range line. Reference to range line between M-1 & M-3 of T11N-R8E.

January 16, 1984 Survey Liber 538, page 487 by Lionel Emery, R.L.S. #24593. Northeast corner of Section 1, T11N-R8E. Found iron rod. Accessories same as on Act 74, Page 41, Vassar Township, shown above.

January 24, 1984 Survey Liber 538, Page 949 by Lionel Emery, R.L.S. #24593. Northeast corner Section 1, T11N-R8E. Found iron rod. Accessories same as on Survey Liber 538, Page 487, shown above.

* Feb. 13, 1892 G. B. Felton, County Surveyor. Survey of Section 30, T12N-R9E, under remarks states: SE cor. Sec. 36, T12N-R8E, maple 20" N14 1/2°E 90.42'.

