
SURVEY & REMONUMENTATION CHOKEN &

MAR 0 5 1998

RECEIVED FOR RECORD LIBER NO. ___ FAGE NO. 79

1997 Remonumentation Program FIFE 13 LAND CORNER RECORDATION CERTIFICATE FIND 101 -5 Pil 4: 00

For corners in Indicatific	Mds Township		1 .0	,	
Tuscola	Located In:	Corner Code #		May 1 May 1	. <u></u> .
1. Public Land Survey	T <u>12N</u> R09 TR TR	E A-1		TUSCOLT COUNTY	
Property Controlling in Section Miscellaneous	TR_ S TR S TR S TR_				
Property in Sec.	S		Reg	ister of Deeds Stam	p & File Number
4. Lot No, Recor 5. Private Claims			1 B	C D E F G	H I J K L M
Renneth D. Dunton requirements of P.A. 74, Michiga conformance with regulations and United States Department of the I that the corner points mentioned Board of Land Surveyors or by recovered, found as expressed be	in P.A. of 1970, the corner parties therefore as required in nterior, Bureau of Land Mannin lines 3, 4 and 5 above we a Decree of a Court of L	coints mentioned in lines 1 and 2 and the current manual of survey instragement or by a decree of a Court of the fulles of the full the fulles of the full the full the full the fulles of the full	above were in uctions of the of Law and /or the Michigan monumented,		101112
NOTE: Not more than 2 com on this certificate.	ers, all in the same town a	and range, may be recorded	9 10—30 11—12—31	32 33 3	27 26 25 34 35 36 36 4 35 36 4 35 36 4 35 36 4 36 4
A. Description of original modec. 27, 1834, Herve 25 & 36, T13N-R8E, HT.C.R.C. witness carl4" Elm, West 19.8' pole. May 30, 1979 N30°W 24.79' MSHD ta Sept. 1, 1982 L.C.R. 1979 survey.	y Parke, D.S. I lemlock 30, N67°E d, C. Black, par to nail in sign survey Liber 498 g in t.p., S30°E C. Page 37 by Du	ntersected range li 17 links, Hemlock ty chief, found pip post, S40°E 85.20' , Page 237 by Dunto 85.06' MSHD tag in nton, L.S. #23503,	ne 2.86 ch. Sou 18, S8 1/2°E 58 e in place. S4 to power pole, n, L.S. #23503. PP, S65°W 109. same object and	3 links. Oct. 15°W 32.0' to 1 S35°W 41.6' to Found pipe in 73' nail & div	l, 1963 nail in o nail in tele. n mon. box. sc in t.p.
B. Description of corner evid Found 3/4" pipe in m same position as ind as the best evidence	onument box and icated on the 19	one accessory that 63 witness card, 19	indicates the c	orner found is 2 L.C.R.C. Ad	s in the ccepted pipe
	•				
				•	
C. Description of monument of Removed 3/4" x 18" pt T13N-R9E, placed mont S13°23'W 53.50' set 1 S88°35'W 21.26' set 1 North 200.55' found of S34°10'E 85.06' found	ipe and placed a ument box over mo 1/2" x 18" rod & 1/2" x 18" rod & conc. mon. & bras	concrete monument vonument. cap #23503. cap #23503. ss cap stamped M-11.	vith standard b T13N-R8E, 199	rass cap stamp	
Corner A-1, T12N-R9E	is common with (Corner A-13, T13N-R9	DE.	WE OF MICHIGAN	*
Signed bySurveyor's Michigan License N	APPR	OVED FORM APPR	OVED BY MICHIGAN STATES	No. 23503	INVEYORS, JAN. 28, 1971 REVISED MAY. 14,1975 REVISED JAN., 1983 REVISED OCT., 1995

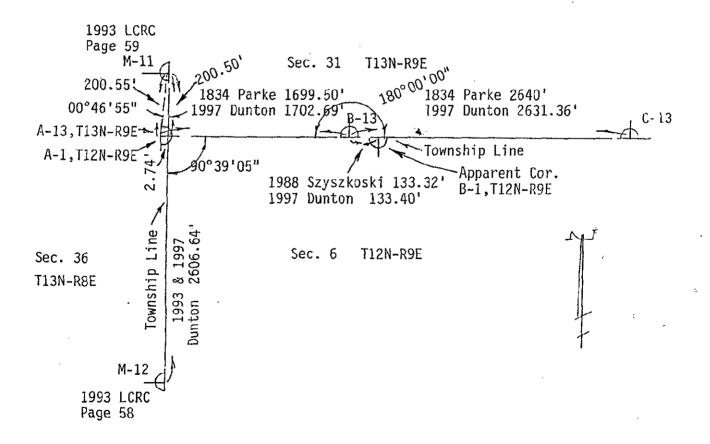

T 7 4

* * *

.