

SURVEY & REMONUMENTATION

MAR 05 1998

RECEIVED FOR RECORD
LIBER NO. _____ PAGE NO. 82

FILE NO. _____
INDIANFIELDS TOWNSHIP
NOV - 5 PM 4:01

SECTION

1997 REMONUMENTATION PROGRAM
LAND CORNER RECORDATION CERTIFICATE
Filing Requirement of Act 74, Mich. P.A. 1970

For corners in Indianfields Twp.

<u>Tuscola</u> (County)	Located In:	Corner Code #
1. Public Land Survey	T <u>12N</u> R <u>09E</u>	<u>C-13</u>
	T _____ R _____	_____
	T _____ R _____	_____
	T _____ R _____	_____
2. Property Controlling in Section	S _____ T _____ R _____	_____
	S _____ T _____ R _____	_____
3. Miscellaneous Property in Sec.	S _____ T _____ R _____	_____
	S _____ T _____ R _____	_____

Gregory M. Dunton
TUSCOLA COUNTY
REGISTER OF DEEDS

COPY

Register of Deeds Stamp & File Number

4. Lot No. _____, Recorded Plat _____
5. Private Claims _____

I, Kenneth D. Dunton, in a field survey on Aug. 16, 1997 do hereby state that under requirements of P.A. 74, Michigan P.A. of 1970, the corner points mentioned in lines 1 and 2 above were in conformance with regulations and rules therefore as required in the current manual of survey instructions of the United States Department of the Interior, Bureau of Land Management or by a decree of a Court of Law and /or that the corner points mentioned in lines 3, 4 and 5 above were in conformance with the rules of the Michigan Board of Land Surveyors or by a Decree of a Court of Law; established, re-established, monumented, recovered, found as expressed below:

NOTE: Not more than 2 corners, all in the same town and range, may be recorded on this certificate.

	A	B	C	D	E	F	G	H	I	J	K	L	M
1													
2	6		5		4		3		2		1		
3													
4	7		8		9		10		11		12		
5													
6	18		17		16		15		14		13		
7													
8	19		20		21		22		23		24		
9													
10	30		29		28		27		26		25		
11													
12	31		32		33		34		35		36		
13													

A. Description of original monument and accessories and/or subsequent restoration:

March 20, 1834 Hervey Parke, D.S. Set post corner Sections 31 & 32. Pine 14" N58 1/2°E 32 1/2 links, Pine 8" N34°W 14 links. Jan. 12-17, 1898 G. B. Felton, Co. Surveyor. Set from measure, cedar post & crockery at corner. Jan. 18-27, 1898 G. B. Felton, Co. Surveyor. Previously set, c.p. & crockery at corner. Oct. 1960 E. C. Parker, Survey Chief with M.S.H.D. Set 3/4" pipe from data given on plans, proj. 79-43, cor. stone had been found by Gar. Steadman, Survey Chief in 1932. N40°E 65.71' p.p., N28°W 81.74' 20" Elm, S29°E 73.94' twin 20" Elm. 1961-62 M.S.H.D. plans, proj. #79041C, object and accessories same as 1960 witness card by Parker. June 29, 1971 survey (unrecorded) by Rowe, L.S. #11192. 3/4" pipe in mon. box.
(Section A con't on back of form)

B. Description of corner evidence found and/or method applied in restoring or reestablishing corner:


Found 3/4" iron rod in monument box and one accessory that indicates the corner found is in the same position as the 1971 survey and 1971 L.C.R.C. Accepted 3/4" rod as the best evidence of the original corner.

C. Description of monument for corner and accessories established to perpetuate locating the position of the corner:

Placed standard brass cap over 3/4" rod found in monument box. Stamped cap C-13, T12N-R9E. Encased cap in concrete in monument box. N11°W 180.59' chiseled "+" atop concrete R.O.W. marker. N26°E 86.37' fnd. P.K. & tag #37276 in NW face p. pole. N42°E 51.23' set 1/2" x 18" rod & cap #23503 at back of curb. S52°E 42.81' set 1/2" x 18" rod & cap #23503 at back of curb. East 143.28' fnd. 5/8" rod in mon. box. Apparent cor. C-1, T11N-R9E.

Signed by *Kenneth D. Dunton*
Surveyor's Michigan License No. 23503

Date 10-20-97

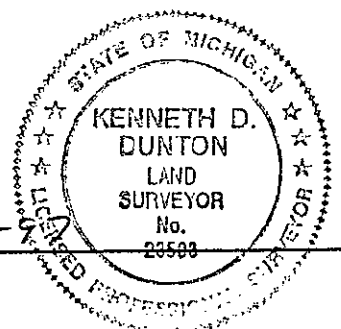

APPROVED
10-20-97
[Signatures]

Section A con't from front of form:

N20°W 102.77' nail & cap in t.p., N25°E 86.17' nail & cap in p.p., S30°W 83.48' nail & cap in p.p. Sept. 1971 L.C.R.C. Page 18 by Rowe, L.S. #11192. Same object and accessories as June 1971 survey. April 3, 1973 survey L-430, P-609 & 610 by Rowe, L.S. #11192. No mention of object or accessories. Oct. 3, 1977 survey L-479, P-792 by Dunton, L.S. #23503 with Rowe Eng. 3/4" pipe in mon. box, N20°W 102.77' nail & cap in t.p., N25°E 86.17' nail & cap in p.p., S05°E 125.02' NW cor. gas station, S20°W 88.89' N. face of sign post. April 19, 1978 survey L-487, P-1361 by Dunton, L.S. #23503 with Rowe Eng. 3/4" pipe in mon. box. South 0.10' centerline pavement, N25°E 86.17' nail & cap in p.p., S05°E 125.02' NW cor. gas station. Oct. 31, 1978 survey L-492, P-1167 by Rowe, L.S. #11192. Object & accessories same as April 1978 survey. July 1985 survey L-552, P-789 & 790 by Owens, L.S. #20709. Object and accessories same as Oct. 1978 survey. Nov. 12, 1993 survey L-655, P-461 & 462 by Field, L.S. #37276. Fnd. 3/4" rod in mon. box, S20°W 88.84' N. face sign post, S05°E 125.01' NW cor. gas station, N30°E 86.66' set P.K. nail & tag #37276 in NW face p. pole, N30°W 62.09' center road sign post. Dec. 14, 1993 survey L-655, P-463 by Field, L.S. #37276. Same object and accessories as Nov. 1993 survey. June 26, 1994 survey L-663, P-439 & 440 by Field, L.S. #37276. Same object and accessories as Dec. 1993 survey.

