

MAR 05 1998

1997 REMONUMENTATION PROGRAM  
LAND CORNER RECORDATION CERTIFICATE  
Filing Requirement of Act 74, Mich. P.A. 1970

RECEIVED FOR RECORD  
LIBER NO. \_\_\_\_\_ PAGE NO. 83  
FILE NO. \_\_\_\_\_  
INDIAN FIELDS TOWNSHIP  
97 NOV -5 PM 4:01

SECTION

For corners in Indianfields Twp.

Tuscola (County)	Located In:	Corner Code #
1. Public Land Survey	T <u>12</u> N R <u>09</u> E	<u>D-13</u>
	T ___ R ___	_____
	T ___ R ___	_____
	T ___ R ___	_____
2. Property Controlling in Section	S ___ T ___ R ___	_____
	S ___ T ___ R ___	_____
3. Miscellaneous Property in Sec.	S ___ T ___ R ___	_____
	S ___ T ___ R ___	_____

*Archie McQueen*  
TUSCOLA COUNTY  
REGISTER OF DEEDS

**COPY**

Register of Deeds Stamp & File Number

4. Lot No. \_\_\_\_\_, Recorded Plat \_\_\_\_\_  
5. Private Claims \_\_\_\_\_

I, Kenneth D. Dunton, in a field survey on Sept. 5, 1997 do hereby state that under requirements of P.A. 74, Michigan P.A. of 1970, the corner points mentioned in lines 1 and 2 above were in conformance with regulations and rules therefore as required in the current manual of survey instructions of the United States Department of the Interior, Bureau of Land Management or by a decree of a Court of Law and /or that the corner points mentioned in lines 3, 4 and 5 above were in conformance with the rules of the Michigan Board of Land Surveyors or by a Decree of a Court of Law; established, re-established, monumented, recovered, found as expressed below:

NOTE: Not more than 2 corners, all in the same town and range, may be recorded on this certificate.

	A	B	C	D	E	F	G	H	I	J	K	L	M
1													
2	6		5		4		3		2		1		
3													
4	7		8		9		10		11		12		
5													
6	18		17		16		15		14		13		
7													
8	19		20		21		22		23		24		
9													
10	30		29		28		27		26		25		
11													
12	31		32		33		34		35		36		
13													

A. Description of original monument and accessories and/or subsequent restoration:

Mar. 20, 1834 Hervey Parke, D.S. Set quarter section post. Hemlock 10" N36°E 20 links, Hemlock 10" N55°W 8 links. Jan. 18-27, 1898 G. B. Felton, Co Surveyor set 1/4 cor. from measure. C. P. & crockery at corner. Jan. 1961 E. C. Parker, Survey Chief, with M.S.H.D. re-established from evidence found in field, set 1/2" iron rod N33°W 32.81' 29" Maple, N38°E 32.17' 21" Maple, N58°E 85.74' NE cor. West hdwl. May 8, 1972 survey L-1, P-492 & 493 by Elrich, L.S. #18986. Fnd. mon. box in conc. pave. N20°W 81.9' top angle iron post, S40°W 121.0' top angle iron post.

(Sec. A con't. on back of form)

B. Description of corner evidence found and/or method applied in restoring or reestablishing corner:


Found 3/4" solid iron bar in mon. box. Distances to C-13 & E-13, T12N-R9E match 1961 ± M.S.H.D. plans. I do not agree with M.S.H.D. location of iron in mon. box as being corner D-13. Felton in 1898 set D-13 by single proportion and applying that same method today, matches the occupied 1/16 lines through the measured mile. Felton measured each half mile at 2651. I now measure them at 2650.44'. Establishing Cor. D-13 by single proportion is the best perpetuation of the original corner position.

C. Description of monument for corner and accessories established to perpetuate locating the position of the corner:

Chiseled "+" in concrete pavement at true position of corner D-13. Placed standard brass cap over 3/4" bar in mon. box as witness monument and encased same in concrete. Stamped cap W.M. D-13, T12N-R9E. The following accessories are to the chiseled "+".  
N02°W 74.84' to base of iron post @ SW end C.V. R/W fence.  
S36°W 93.74' to base of iron post @ NW end C.V. R/W fence.  
East 38.22' set W.M. in conc. in mon. box (W.M. is on township line).  
N89°E 133.60' fnd. 1" iron bar in mon. box @ apparent cor. D-1, T11N-R9E.

Signed by *Kenneth D. Dunton*  
Surveyor's Michigan License No. 23503

Date 10-20-97

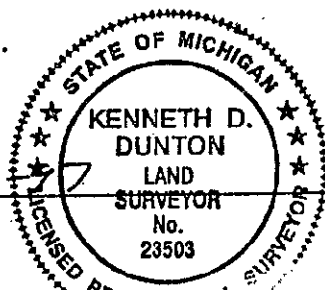

APPROVED  
10-20-97  
*[Signature]*

Sec. A con't from front of form:

April 3, 1973 survey L-430, P-609 & 610 by Rowe, L.S. #11192. Fnd. mon. box, N20°W 81.9' top of angle iron post, S40°W 121.0' top of angle iron post. Aug. 30, 1973 survey L-436, P-731 by Elrich, L.S. #18986. Same object and accessories as L-1, P-492 & 493. Sept. 14, 1977 survey L-479, P-801 & 802 by Dunton, L.S. #23503, with Rowe Eng. No object stated, S88°27'18"W 93.98' from centerline of Bruisee Road. April 19, 1978 survey L-487, P-1361 by Dunton, L.S. #23503 with Rowe Eng. 3/4" iron in mon. box. South 0.25' centerline pavement, N 40°W 81.86' to angle iron post, S60°W 120.93' top angle iron post c.v. fence. Oct. 31, 1978 survey L-492, P-1167 by Rowe, L.S. #11192. No mention of object found or accessories. July 1985 survey L-552, P-789 & 790 by Owens, L.S. #20709. Fnd. 3/4" iron rod in mon. box. South 0.25' centerline pavement, N40°W 81.96' to angle iron post, S60°W 120.93' top angle iron post c.v. fence, S40°E 100.55' nail & disc t.p. S45°E 98.45' "+" on conc. headwall (1310+03). June 26, 1994 survey L-663, P-439 & 440 by Field, L.S. #37276. No mention of object or accessories.

