

SURVEY & REMONUMENTATION

MAR 05 1998

1997 REMONUMENTATION PROGRAM

LAND CORNER RECORDATION CERTIFICATE
Filing Requirement of Act 74, Mich. P.A. 1970

RECEIVED FOR RECORD
LIBER NO. _____ PAGE NO. 85
FILE NO. _____
INDIAN FIELDS TOWNSHIP
97 NOV -5 PM 4:01

SECTION

For corners in Indianfields Twp.

<u>Tuscola</u> (County)	Located In:	Corner Code #
1. Public Land Survey	T12N R09E	F-13
	T ___ R ___	_____
	T ___ R ___	_____
	T ___ R ___	_____
2. Property Controlling in Section	S ___ T ___ R ___	_____
	S ___ T ___ R ___	_____
3. Miscellaneous Property in Sec.	S ___ T ___ R ___	_____
	S ___ T ___ R ___	_____

[Signature]
TUSCOLA COUNTY
REGISTER OF DEEDS

COPY

Register of Deeds Stamp & File Number

4. Lot No. _____, Recorded Plat _____
5. Private Claims _____

I, Kenneth D. Dunton, in a field survey on Sept. 5, 1997 do hereby state that under requirements of P.A. 74, Michigan P.A. of 1970, the corner points mentioned in lines 1 and 2 above were in conformance with regulations and rules therefore as required in the current manual of survey instructions of the United States Department of the Interior, Bureau of Land Management or by a decree of a Court of Law and for that the corner points mentioned in lines 3, 4 and 5 above were in conformance with the rules of the Michigan Board of Land Surveyors or by a Decree of a Court of Law; established, re-established, monumented, recovered, found as expressed below:

NOTE: Not more than 2 corners, all in the same town and range, may be recorded on this certificate.

1	A	B	C	D	E	F	G	H	I	J	K	L	M
2		6		5		4		3		2		1	
3													
4		7		8		9		10		11		12	
5													
6		10		17		16		15		14		13	
7													
8		19		20		21		22		23		24	
9													
10		30		29		28		27		26		25	
11													
12		31		32		33		34		35		36	
13													

A. Description of original monument and accessories and/or subsequent restoration:

March 20, 1834 Hervey Parke, D.S. Set quarter section post. Cedar 15" N81°W 35 links, Cedar 12" N61 1/2°E 20 1/2 links. March 20-24, 1900 G. B. Felton, Co. Surveyor, Survey of Section 33, T12N-R9E. S 1/4 corner set from measure, iron post at corner. Jan. 1961 M.S.H.D. witness card, E. C. Parker, Survey Chief, re-established from evidence found in field. Set 1/2" iron rod. N12°W 23.94' W. end culvert, N43°E 30.50' E. end culvert, S67°E 71.05' 24" Elm, 3.86' N. of survey centerline M-46. Oct. 19, 1971 Mortgage survey L-1, P-265 by Sides, L.S. #13042. No object stated. North 70.5' sign post, East 101.75' mon. box.

(Sec. A con't on back of form)

B. Description of corner evidence found and/or method applied in restoring or reestablishing corner:


Found boat spike in monument box and one accessory that indicates the corner found is in the same position as the 1961 witness card. Accepted boat spike as the best evidence of the original corner.

C. Description of monument for corner and accessories established to perpetuate locating the position of the corner:

Placed standard brass cap over boat spike found in monument box. Stamped cap F-13, T12N-R9E. Encased cap in concrete in monument box.
N10°W 56.35' West end of 45' of 12" C.S.P. drive culvert.
N30°E 67.15' East end of 45' of 12" C.S.P. drive culvert.
N60°E 146.09' fnd. P.K. nail & disc. #37276 in W. face p. pole.
East 101.53' fnd. 1" iron rod in mon. box at apparent corner F-1, T11N-R9E.
South 3.85' centerline joint of E-W concrete pavement.

Signed by [Signature]
Surveyor's Michigan License No. 23503

Date 10-20-97

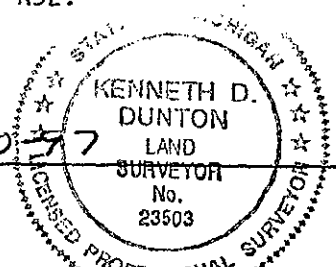

APPROVED
10-20-97
[Signature]

