

LAND CORNER RECORDATION CERTIFICATE

Filing Requirement of Act 74, Mich. P.A. 1970  
1995 REMONUMENTATION PROGRAM

For corners in INDIANFIELDS TWP.

TUSCOLA Located in: Corner Code #

RECEIVED FOR RECORD  
LIBER NO. \_\_\_\_\_ PAGE NO. \_\_\_\_\_  
FILING NO. #76  
Indianfields Twp  
95 OCT 30 AM 9:34  
VIRGINIA M. MOLARET  
TUSCOLA COUNTY  
REGISTER OF DEEDS

1. Public Land Survey T 12N R 09E G-2  
T \_\_\_\_\_ R \_\_\_\_\_  
T \_\_\_\_\_ R \_\_\_\_\_  
T \_\_\_\_\_ R \_\_\_\_\_  
T \_\_\_\_\_ R \_\_\_\_\_  
2. Property Controlling S \_\_\_\_\_ R \_\_\_\_\_  
in Section S \_\_\_\_\_ R \_\_\_\_\_  
3. Miscellaneous S \_\_\_\_\_ R \_\_\_\_\_  
Property in Sec. S \_\_\_\_\_ R \_\_\_\_\_

Register of Deeds Stamp & File Number

4. Lot No. \_\_\_\_\_ Recorded Plat \_\_\_\_\_  
5. Private Claims \_\_\_\_\_

	A	B	C	D	E	F	G	H	I	J	K	L	M
1													
2	6	5	4	3	2	1							
3													
4	7	8	9	10	11	12							
5													
6	18	17	16	15	14	13							
7													
8	19	20	21	22	23	24							
9													
10	30	29	28	27	26	25							
11													
12	31	32	33	34	35	36							
13													


I, JONATHAN M. FIELD, in a field survey on SEPTEMBER 1 19 95 do hereby certify that under requirements of P.A. 74, Michigan P.A. of 1970, the corner points mentioned in lines 1 and 2 above were in conformance with regulations and rules therefore as required in the current manual of survey instructions of the United States Department of the Interior, Bureau of Land Management or by a decree of a Court of Law and/or that the corner points mentioned in lines 3, 4 and 5 above were in conformance with the rules of the Michigan Board of Land Surveyors or by a Decree of a Court of Law; established, re-established, monumented, re-monumented, recovered, found as expressed below:

NOTE: Not more than 4 corners, all in the same town and range, may be recorded on this certificate.

- A. Description of original monument and accessories and/or subsequent restoration:
- 1835 GLO; RISDON, D.S.; SET POST; BEECH 9 N39E 11LKS., BEECH 12 S63W 44LKS.
  - 1954 DETROIT EDISON; MACAY; UNRECORDED SURVEY; BOLT HOLE IN M.H. COVER; NO WITS GIVEN
  - 1958-1966 BLACK, P.S.#3384; UNRECORDED SURVEYS SHOW CORNER; NO OBJECT STATED; NO WITS GIVEN
  - 1971 ROWE ENG.; ROWE, P.S.#11192; SURVEY L.1 PG.268; MARK ON M.H. COVER; N45E 46.83' USGS MON N50W 60.38' SE COR OF HOUSE, S80W 48.91' NE COR OF PORCH .
  - 1971 ROWE ENG.; ROWE, P.S.#11192; SURVEY L.1 PG.633-4; NO OBJECT STATED, NO WITS GIVEN
  - 1972 ROWE ENG.; ROWE, P.S.#11192; SURVEY L.472 PG.893-4; NO OBJECT STATED, NO WITS GIVEN
  - 1972 ROWE ENG.; ROWE, P.S.#11192; SURVEY L.2 PG.379-80; MARK ON M.H. COVER, SAME WITS AS 1971
  - 1972 ROWE ENG.; ROWE, P.S.#11192; SURVEY L.2 PG.97; FND + ON M.H. COVER; NO WITS GIVEN
  - 1973 ROWE ENG.; ROWE, P.S.#11192; SURVEY L.433 PG.132-3; MARK ON M.H. COVER; N45E 46.83' USGS MON, N50W SE COR HOUSE, N85W 18.18' STOP SIGN POST
  - 1973 KAY ENG.; KAY, P.S.#14096; SURVEY L.449 PG.954; NO OBJECT STATED; N45E 46.78' BENCH MARK WEST 56.48' NE COR HOUSE, WEST 33.0' 5/8" ROD
  - 1973 ROWE ENG.; ROWE, P.S.#11192; SURVEY L.441 PG. 330; NO OBJECT STATED, NO WITS GIVEN
  - 1974 ROWE ENG.; ROWE, P.S.#11192; SURVEY L.441 PG.329; MARK ON M.H. COVER, SAME WITS AS 1971
  - 1974 ROWE ENG.; ROWE, P.S.#11192; SURVEY L.441 PG.331; MARK ON M.H. COVER, SAME WITS AS 1973
  - 1974 ROWE ENG.; ROWE, P.S.#11192; SURVEY L.443 PG.256; MARK ON M.H. COVER, SAME WITS AS 1973
  - 1974 ROWE, P.S.#11192; LCRC PG.20; FND MARK ON M.H. COVER; SAME WITS AS 1973 REI SURVEY ABOVE
  - 1975 ROWE ENG.; BECK, P.S.#21559; SURVEY L.452 PG.629-30; MARK ON MH COVER; SAME WITS AS 1973

B. Description of corner evidence found and/or method applied in restoring or reestablishing corner:  
1995 ROWE ENG.; FIELD, P.S.#37276; FND CHIS. + ON M.H. COVER (ALIGNMENT MARKS MATCH) AT C/L-C/L FRANK STREET AND HOOPER STREET; RECOVERED 3 PREVIOUS WITS INDICATING THAT CHIS. + IS IN SAME POSITION AS 1971 MARK ON M.H. COVER CITED ABOVE  
ACCEPTED FND + ON MH COVER AS BEST EVIDENCE OF ORIGINAL CORNER POSITION

C. Description of monument for corner and accessories established to perpetuate locating the position of the corner:  
G-2 FND. CHIS. + ON MH COVER (WITNESSES ARE TO CORNER G-2)  
N59°W, 60.17' SE CORNER OF HOUSE (ALUMINUM SIDING)  
S77°W, 48.91' NE CORNER OF HOUSE (CONC. BLOCK FOUNDATION)  
S39°W, 36.98' SET NAIL W/REMON TAG IN SE FACE P.POLE  
S19°E, 79.57' FND. NAIL W/TAG #11192 IN W. FACE T.POLE  
N46°E, 46.90' CENTER OF BRASS DISK AT NE CORNER OF B/WALKS  
N20°E, 80.75' FND. NAIL W/TAG #11192 IN W. FACE P.POLE  
WEST, 16.00' SET WITNESS MONUMENT IN MON. BOX ON LINE H-2 THRU G-2  
STAMPED CAP "G 2 T12N R9E"

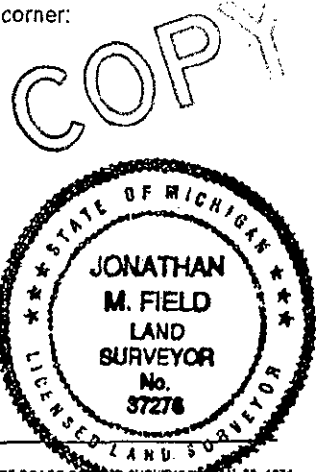

Signed by Jonathan M. Field Date 10-27-95

Surveyor's Michigan License No. 37276

APPROVED  
10-16-95  
*[Signatures]*

FORM APPROVED BY MICHIGAN STATE BOARD OF LAND SURVEYORS, JULY 28, 1971  
REVISED MAY 14, 1975  
REVISED JAN, 1983  
ADAPTED FOR WORD PROCESSING MARCH, 1983

DEC 1 1995  
COMMISSION

