

LAND CORNER RECORDATION CERTIFICATE

Filing Requirement of Act 74, Mich. P.A. 1970  
1995 REMONUMENTATION PROGRAM

For corners in INDIANFIELDS TWP.

TUSCOLA (County)	Located In:	Corner Code #
1. Public Land Survey	T 12N R 09E	G-3
	T _____ R _____	_____
	T _____ R _____	_____
	T _____ R _____	_____
2. Property Controlling in Section	S _____ T _____ R _____	_____
	S _____ T _____ R _____	_____
3. Miscellaneous Property in Sec.	S _____ T _____ R _____	_____
	S _____ T _____ R _____	_____

RECEIVED FOR RECORD  
LIBER NO. \_\_\_\_\_ PAGE NO. \_\_\_\_\_  
FILING NO. #77  
Indianfields Twp  
95 OCT 30 AM 9:34  
VIRGINIA M. McLAUREN  
TUSCOLA COUNTY  
REGISTER OF DEEDS  
Register of Deeds Stamp & File Number

4. Lot No. \_\_\_\_\_, Recorded Plat \_\_\_\_\_  
5. Private Claims \_\_\_\_\_

I, JONATHAN M. FIELD, in a field survey on SEPTEMBER 1 19 95 do hereby certify that under requirements of P.A. 74, Michigan P.A. of 1970, the corner points mentioned in lines 1 and 2 above were in conformance with regulations and rules therefore as required in the current manual of survey instructions of the United States Department of the Interior, Bureau of Land Management or by a decree of a Court of Law and/or that the corner points mentioned in lines 3, 4 and 5 above were in conformance with the rules of the Michigan Board of Land Surveyors or by a Decree of a Court of Law; established, re-established, monumented, re-monumented, recovered, found as expressed below:

A	B	C	D	E	F	G	H	I	J	K	L	M
1												
2	6	5	4	3	2	1						
3												
4	7	8	9	10	11	12						
5												
6	18	17	16	15	14	13						
7												
8	19	20	21	22	23	24						
9												
10	30	29	28	27	26	25						
11												
12	31	32	33	34	35	36						
13												

NOTE: Not more than 4 corners, all in the same town and range, may be recorded on this certificate.


A. Description of original monument and accessories and/or subsequent restoration:  
1835 GLO; RISDON, D.S.; SET POST; SUGAR 14 S69W 9LKS., SUGAR 12 N69E 60LKS.  
1954 DETROIT EDISON; MACAY; UNRECORDED SURVEY; RIVET HEAD IN M.H. COVER; NO WITS GIVEN  
1954-1964 BLACK, P.S.#3384; UNRECORDED SURVEYS SHOW CORNER; NO OBJECT STATED; NO WITS GIVEN  
1965 SPICER ENG.; MARTIN, P.S.#4699; UNRECORDED SURVEY; NO OBJECT STATED; NO WITS GIVEN  
1971 ROWE ENG.; ROWE, P.S.#11192; SURVEY L.1 PG.633-4; NO OBJECT STATED, NO WITS GIVEN  
1972 HENDERSON-BATES; ELRICH, P.S.#18986; SURVEY L.1 PG.609; FND T-BAR; N65W 69.50' NAIL W/CAP IN T.P., N15W 47.60' NAIL W/CAP IN P.P., N60W 54.62' TOP OF HYDRANT  
1972 ROWE, P.S.#11192; LCRC PG.3; FND NAIL/SET T-IRON; N65W 69.50' NAIL W/CAP IN T.POLE, N60W 54.62' TOP OF HYDRANT, N15W 47.60' NAIL W/CAP IN P.POLE, S65W 43.73' P.C. JOINT IN CURB  
1972 ROWE ENG.; ROWE, P.S.#11192; SURVEY L.472 PG.893-4; SET T-IRON; SAME WITS AS 1972 LCRC  
1972 ROWE ENG.; ROWE, P.S.#11192; SURVEY L.2 PG.103-4; SET T-IRON; SAME WITS AS 1972 LCRC  
1972 ROWE ENG.; ROWE, P.S.#11192; SURVEY L.433 PG.148-9; T-IRON; SAME WITS AS 1972 LCRC ABOVE  
1973 ROWE ENG.; ROWE, P.S.#11192; SURVEY L.433 PG.132-3; T-IRON; SAME WITS AS 1972 LCRC ABOVE  
1973 KAY ENG.; KAY, P.S.#14096; SURVEY L.449 PG.954; FND LUG IN MH COVER; N30W 50.5' P.P., N25E 124.92' SW COR GAS STATION, N60W 55.35' SW COR STONE PILLAR  
1973 ROWE ENG.; ROWE, P.S.#11192; SURVEY L.441 PG. 330; T-IRON; SAME WITS AS 1972 LCRC ABOVE  
1974 ROWE ENG.; ROWE, P.S.#11192; SURVEY L.443 PG.256-7; T-IRON; SAME WITS AS 1972 LCRC ABOVE  
1974 HENDERSON-BATES; ELRICH, P.S.#18986; SURVEY L.446 PG.181; FND T-BAR; SAME WITS AS 1972  
1975 ROWE ENG.; BECK, P.S.#21559; SURVEY L.452 PG.629-30; T-IRON; SAME WITS AS 1972 LCRC  
1975 ROWE ENG.; BECK, P.S.#21559; SURVEY L.482 PG.615-6; T-IRON; SAME WITS AS 1972 LCRC ABOVE

SECTION A. CONTINUED ON BACK  
B. Description of corner evidence found and/or method applied in restoring or reestablishing corner:  
1995 ROWE ENG.; FIELD, P.S.#37276; FND CHIS. + ON M.H. COVER (ALIGNMENT MARKS MATCH) AT C/L-C/L VAN GEISEN ROAD AND HOOVER STREET; RECOVERED 2 PREVIOUS WITS INDICATING THAT CHIS. + IS IN SAME POSITION AS 1972 T-IRON CITED ABOVE

ACCEPTED FND + ON MH COVER AS BEST EVIDENCE OF ORIGINAL CORNER POSITION  
C. Description of monument for corner and accessories established to perpetuate locating the position of the corner:  
G-3 FND. CHIS. + ON MH COVER (WITNESSES ARE TO CORNER G-3)  
SOUTH, 65.47' FND. 3/4" ROD IN MON BOX  
N61°W, 54.64' TOP CENTER OF HYDRANT  
N28°W, 47.63' FND. NAIL W/ BOTTLE CAP IN S. FACE P.POLE  
SOUTH, 25.69' FND. 1/2" ROD AT B/CURB  
WEST, 75.24' FND. 1/2" ROD AT B/CURB  
N45°E, 40.10' SET CHIS. + IN TOP OF SW'LY BOLT OF LIGHT POLE SOUTH, 24.01' SET MONUMENT IN MON. BOX ON LINE G-3 TO G-4 STAMPED CAP "G 3 W.C.  
S22°E, 51.30' FND. P-K NAIL W/MSHD TAG IN C/L M-81 T12N R9E"  
S28°E, 85.76' FND. NAIL W/TAG #11192 IN N. FACE P.POLE  
S46°W, 113.93' FND. NAIL W/TAG #11192 IN S. FACE P.POLE

Signed by Jonathan M. Field Date 10-27-95  
Surveyor's Michigan License No. 37276

APPROVED  
10-16-95  
L.M.E.  
gmg

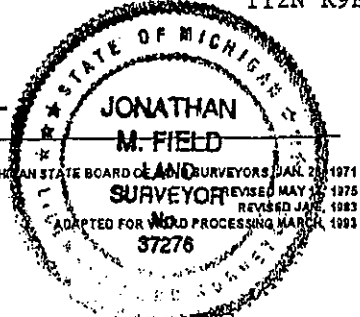

DEC 01 1995  
COMMISSION

1978 ROWE ENG.; DUNTON, P.S.#23503; SURVEY L.489 PG.889-90; LUG ON MH COVER; EAST 65.76' P-K NAIL IN C/L JOINT M-81, S25W 61.84' PT JOINT IN CURB, N65W 69.78' CAP IN P.P.

1978 ROWE ENG.; FOKENS, P.S.#21567; SURVEY L.504 PG.356; SAME WITS AS 1978 SURVEY ABOVE ALSO N60W 54.68' TOP HYDRANT

1980 LEACH ENG.; LEACH, P.S.#7236; SURVEY L.503 PG.1486-7; CROSS ON MH COVER; SAME WITS AS 1972 LCRC

1980 ROWE ENG.; FOKENS, P.S.#21567; SURVEY L.504 PG.356; LUG ON MH COVER; SAME WITS AS 1978 SURVEY

1980 LEACH ENG.; LEACH, P.S.#7236; SURVEY L.505 PG.543-4; NO OBJECT STATED; SAME WITS AS 1972 LCRC

1981 ROWE ENG.; ROWE, P.S.#11192; SURVEYS L.514 PG.642-5; LUG ON MH COVER; SAME WITS AS 1980 SURVEY PLUS N15W 47.62' CAP IN P.POLE

1981 ROWE ENG.; ROWE, P.S.#11192; SURVEY L.514 PG.1456-7; LUG ON MH COVER; SAME WITS AS 1980 SURVEY ABOVE

1981 ROWE ENG.; ROWE, P.S.#11192; SURVEY L.522 PG.309-10; LUG ON MH COVER; SAME WITS AS 1981 SURVEY ABOVE

1982 ROWE ENG.; BOLDT, P.S.#28405; SURVEY L.536 PG.1035-6; LUG ON MH COVER; SAME WITS AS 1981 SURVEY ABOVE

1982 ROWE ENG.; BOLDT, P.S.#28405; SURVEY L.536 PG.1315; LUG ON MH COVER; SAME WITS AS 1981 SURVEY ABOVE

1984 ROWE ENG.; WINIARSKI, P.S.#23857; SURVEY L.547 PG.1440-1; MADE SCRATCH IN MH COVER; SOUTH 25.69' 1/2 ROD @ B/CURB, WEST 75.24' 1/2' ROD @ B/CURB, N65W 69.78' NAIL W/CAP IN P.POLE, N60W 54.68' TOP HYDRANT, N15W 47.62' NAIL W/CAP IN P.POLE

1984 ROWE ENG.; ROWE, P.S.#11192; SURVEY L.547 PG.745-6; FND SCRATCH IN MH COVER; N65W 69.78' NAIL W/CAP IN P.POLE, N60W 54.68' TOP HYDRANT, N15W 47.62' NAIL W/CAP IN P.POLE, S88E 66.6' P-K C/L M-81

1985 EMERY, P.S.#24593; SURVEY L.553 PG.363-4, 807-12, 1169; FND + IN MH COVER; N65W 69.55' NAIL W/CAP IN T.POLE, N60W 54.43' TOP HYDRANT, N15W 47.75' NAIL W/CAP IN P.POLE, WEST 27.74' NW COR PLANTER, S30W 10.74' NE COR PLANTER

1986 DUNTON, P.S.#23503; SURVEY L.578 PG.20; + ON MH COVER; SAME WITS AS 1985 SURVEY ABOVE

1986 EMERY, P.S.#24593; SURVEY L.624 PG.549; + ON MH COVER; SAME WITS AS 1985 SURVEY ABOVE

1987 HENDERSON-BATES; EMERY, P.S.#24593; SURVEY L.568 PG.559; + ON MH COVER; SAME WITS AS 1985 SURVEY ABOVE

1988 DUNTON, P.S.#23503; SURVEY L.587 PG.80-1; NO OBJECT STATED; NO WITS GIVEN

1988 DUNTON, P.S.#23503; SURVEY L.587 PG.84-5; NO OBJECT STATED; NO WITS GIVEN

1988 ROWE ENG.; BROWN, P.S.#33134; SURVEY L.585 PG.1281-3; SET POINT FROM PREV WITS; SAME WITS AS 1984 SURVEY L.547 PG.1440 ABOVE PLUS SW 0.50' CHIS. +

1988 DUNTON, P.S.#23503; NOTES FROM UNRECORDED SURVEY JOB NO. 1027-88; FND + ON MH COVER TO BE INCORRECT; RESET + ON MH AT AVERAGE POSITION INDICATED BY RETRACEMENT OF SEVERAL SURVEYS

1988 ROWE ENG.; SZYSZKOSKI, P.S.#33986; SURVEY L.588 PG.876-7; SET POINT FROM PREV WITS; SAME WITS AS 1988 REI SURVEY ABOVE

1989 ROWE ENG.; SZYSZKOSKI, P.S.#33986; SURVEY L.594 PG.890-1; SET POINT FROM PREV WITS; SAME WITS AS 1988 REI SURVEY ABOVE

1989 EMERY, P.S.#24593; SURVEY L.596 PG.1015; NO OBJECT STATED; SAME WITS AS 1985 EMERY SURVEY ABOVE

1989 EMERY, P.S.#24593; SURVEY L.599 PG.945; NO OBJECT STATED; SAME WITS AS 1985 EMERY SURVEY ABOVE

1990 R.C. ENG.; FERGUSON, P.S.#26454; SURVEY L.605 PG.900; FND + ON MH COVER; SAME WITS AS 1985 EMERY SURVEY ABOVE

1991 ROWE ENG.; BROWN, P.S.#33134; SURVEY L.618 PG.295-9; FND + ON MH COVER; SOUTH 65.47' FND 3/4" ROD IN MON. BOX, N61W 54.54' TOP CENTER OF HYDRANT, N28W 47.63' FND NAIL W/BOTTLE CAP IN P.POLE, SOUTH, 25.69' FND 1/2" ROD @ B/CURB, WEST 75.24' FND 1/2" ROD @ B/CURB, S54W 0.50' FND CHIS. + ON MH COVER

1992 ROWE ENG.; FIELD, P.S.#37276; SURVEY L.640 PG.997-8; FND + ON MH COVER; SAME WITS AS 1991 SURVEY

1992 FIELD, P.S.#37276; LCRC PG.66; FND + ON MH COVER; SAME WITS AS 1991 SURVEY

1992 WADE-TRIM; MCGINNIS, P.S.#18999; SURVEY L.652 PG.1371-2; FND + ON MH COVER; NO WITS GIVEN

