

LAND CORNER RECORDATION CERTIFICATE

Filing Requirement of Act 74, Mich. P.A. 1970
1995 REMONUMENTATION PROGRAM

For corners in INDIANFIELDS TWP.
TUSCOLA Located In: _____ Corner Code # _____
(County)

1. Public Land Survey	T	12N	R	09E	H-2
	T		R		
	T		R		
	T		R		
2. Property Controlling in Section	S	T	R		
	S	T	R		
3. Miscellaneous Property in Sec.	S	T	R		
	S	T	R		

4. Lot No. _____, Recorded Plat _____
5. Private Claims _____

RECEIVED FOR RECORD
LIBER NO. _____ PAGE NO. _____
FILING NO. # 73
95 OCT 30 AM 9:34
Indianafields Twp
VIRGINIA H. McCLAREN
TUSCOLA COUNTY
REGISTER OF DEEDS
Register of Deeds Stamp & File Number

I, JONATHAN M. FIELD, in a field survey on SEPTEMBER 1 19 95, do hereby certify that under requirements of P.A. 74, Michigan P.A. of 1970, the corner points mentioned in lines 1 and 2 above were in conformance with regulations and rules therefore as required in the current manual of survey instructions of the United States Department of the Interior, Bureau of Land Management or by a decree of a Court of Law and/or that the corner points mentioned in lines 3, 4 and 5 above were in conformance with the rules of the Michigan Board of Land Surveyors or by a Decree of a Court of Law, established, re-established, monumented, re-monumented, recovered, found as expressed below:

NOTE: Not more than 4 corners, all in the same town and range, may be recorded on this certificate.

	A	B	C	D	E	F	G	H	I	J	K	L	M
1													
2	6	5	4	●					2	1			
3													
4	7	8	9	10	11	12							
5													
6	18	17	16	15	14	13							
7													
8	19	20	21	22	23	24							
9													
10	30	29	28	27	26	25							
11													
12	31	32	33	34	35	36							
13													

A. Description of original monument and accessories and/or subsequent restoration:

NOT SET AS PART OF ORIGINAL G.L.O. SURVEY


- 1964 BLACK, P.S.#3384; UNRECORDED SURVEY SHOWS CORNER; NO OBJECT STATED, NO WITS GIVEN
- 1972 ROWE ENG.; ROWE, P.S.#11192; SURVEY L.2 PG.18; NO OBJECT STATED; NO WITS GIVEN
- 1972 ROWE ENG.; ROWE, P.S.#11192; SURVEY L.2 PG.379-80; FND + ON MH COVER; NO WITS GIVEN
- 1972 ROWE ENG.; ROWE, P.S.#11192; SURVEY L.2 PG.97; FND + ON MH COVER; NO WITS GIVEN
- 1973 EDMANDS ENG.; MCGINNIS, P.S.#18999; UNRECORDED SURVEY FOR VILLAGE OF CARO, JOB NO. 9174 CHIS. + ON MH; NO WITS GIVEN
- 1973 ROWE ENG.; ROWE, P.S.#11192; SURVEY L.438 PG.805-7; NO OBJECT STATED; NO WITS GIVEN
- 1973 ROWE ENG.; ROWE, P.S.#11192; SURVEY L.441 PG.339-40; NO OBJECT STATED; NO WITS GIVEN
- 1974 ROWE ENG.; ROWE, P.S.#11192; SURVEY L.441 PG.329; NO OBJECT STATED; NO WITS GIVEN
- 1974 ROWE ENG.; ROWE, P.S.#11192; SURVEY L.441 PG. 331; NO OBJECT STATED; NO WITS GIVEN
- 1977 KAY ENG.; KAY, P.S.#14096; SURVEY L.469 PG.939-40; FND + ON MH COVER; N45E 45.77' SW COR BLDG, S30E 41.65' TOP HYDRANT, S45W 63.40' NE COR BLDG.
- 1977 ROWE ENG.; DUNTON, P.S.#23503; SURVEY L.477 PG.855-6; + ON MH COVER; N45E 45.79' SW COR BLDG, S45W 63.40' NE COR HOTEL, S70E 71.50' CTR FLAG POLE, N45W 90.09' SE COR GAS STA.
- 1977 DUNTON, P.S.#23503; LCRC PG.40; FND + ON MH COVER; SAME WITS AS 1977 REI SURVEY ABOVE
- 1978 EDMANDS ENG.; MACDONALD, P.S.#22438; SURVEY L.488 PG.11; FND + ON MH COVER; NO WITS

B. Description of corner evidence found and/or method applied in restoring or reestablishing corner:

1995 ROWE ENG.; FIELD, P.S.#37276; CHIS. + ON MH COVER (ALIGNMENT MARKS MATCH) AT C/L-C/L FRANK STREET AND ALMER STREET; RECOVERED 3 PREVIOUS WITS INDICATING THAT FND + IS IN POSITION AS 1977 SURVEY CITED ABOVE
ACCEPTED FND + ON MH COVER AS BEST EVIDENCE OF CORNER POSITION

C. Description of monument for corner and accessories established to perpetuate locating the position of the corner:

H-2 FND. CHIS., + ON MH COVER (WITNESSES ARE TO CORNER H-2)
N45°E, 45.77' SW CORNER CONC. BLOCK BLDG. (ROUNDED CORNER)
S59°E, 65.80' CENTER OF E'LY FLAG POLE
S29°E, 41.98' TOP CENTER OF HYDRANT
S54°W, 63.40' NE CORNER OF OLD HOTEL MONTAGUE (CUT STONE)
N48°W, 89.49' SE CORNER OF BRICK BLDG. (MOST E'LY CORNER)
SOUTH, 16.00' SET WITNESS MONUMENT IN MON. BOX IN LINE H-2 TO H-3
STAMPED CAP "H 2 W.C. T12N R9E"

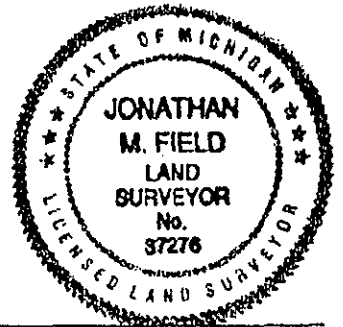

Signed by Jonathan M. Field Date 10-27-95
Surveyor's Michigan License No. 37276

APPROVED
10-16-95

FORM APPROVED BY MICHIGAN STATE BOARD OF LAND SURVEYORS, JAN. 28, 1974
REVISED MAY 14, 1975
REVISED JAN., 1983
ADAPTED FOR WORD PROCESSING MARCH, 1993

SURVEY &
RECORDATION

DEC 01 1995

COMMISSION

COPY

