

MAR 05 1998

RECEIVED FOR RECORD
LIBER NO. _____ PAGE NO. 87
FILE NO. _____
INDIANFIELDS TOWNSHIP
97 NOV -5 PM 4:02

SECTION

1997 REMONUMENTATION PROGRAM
LAND CORNER RECORDATION CERTIFICATE
Filing Requirement of Act 74, Mich. P.A. 1970

For corners in Indianfields Twp.

Tuscola (County)	Located In:	Corner Code #
1. Public Land Survey	T12N R 09E	H-13
	T _____ R _____	_____
	T _____ R _____	_____
	T _____ R _____	_____
2. Property Controlling in Section	S _____ T _____ R _____	_____
	S _____ T _____ R _____	_____
3. Miscellaneous Property in Sec.	S _____ T _____ R _____	_____
	S _____ T _____ R _____	_____

[Signature]
TUSCOLA COUNTY
REGISTER OF DEEDS

COPY

Register of Deeds Stamp & File Number

4. Lot No. _____, Recorded Plat _____
5. Private Claims _____

I, Kenneth D. Dunton, in a field survey on Sept. 5, 1997 do hereby state that under requirements of P.A. 74, Michigan P.A. of 1970, the corner points mentioned in lines 1 and 2 above were in conformance with regulations and rules therefore as required in the current manual of survey instructions of the United States Department of the Interior, Bureau of Land Management or by a decree of a Court of Law and/or that the corner points mentioned in lines 3, 4 and 5 above were in conformance with the rules of the Michigan Board of Land Surveyors or by a Decree of a Court of Law; established, re-established, monumented, recovered, found as expressed below:

	A	B	C	D	E	F	G	H	I	J	K	L	M
1													
2	6		5		4		3		2		1		
3													
4	7		8		9		10		11		12		
5													
6	10		17		16		15		14		13		
7													
8	19		20		21		22		23		24		
9													
10	30		29		28		27		26		25		
11													
12	31		32		33		34		35		36		
13													

NOTE: Not more than 2 corners, all in the same town and range, may be recorded on this certificate.

A. Description of original monument and accessories and/or subsequent restoration:

March 19, 1834 Hervey Parke, D.S. set quarter section post. Cedar 11" N10°W 20 1/2 links, Lynn 10" N87°E 24 1/2 links. Jan. 1961 M.S.H.D. witness card, E. C. Parker, Survey Chief, re-established from evidence found in field. Set 1/2" iron rod. N30°W 57.32' fen. post, North 49.28' fen. post, N35°E 57.34' fen. post, S45°E 78.50' cor. fen. post, South 1.66' centerline M-46. June 28, 1983 L.C.R.C. by Emery, L.S. #24593. Found boat spike in mon. box. N50°E 16.2' N. edge pavt. @ joint, East 58.15' center of mon. box cover, S45°E 18.3' S. edge pavt. @ joint, South 1.6' centerline of pavement. June 29, 1983 surveys L-533, P-836 & 837 and L-533, P-1207 & 1208. Object and accessories same as L.C.R.C. Page 50. (Sec. A con't on back of form)

B. Description of corner evidence found and/or method applied in restoring or reestablishing corner:


Found boat spike in monument box at Southerly extension of fence line North. Found one accessory that indicates the corner is in the same position as the 1961 witness card. Accepted boat spike as the best evidence of the original corner.

C. Description of monument for corner and accessories established to perpetuate locating the position of the corner:

Placed standard brass cap over boat spike found in monument box. Stamped cap H-13, T12N-R9E. Encased cap in concrete in monument box. North 76.07' set T.C. Remon. tag & spike in W. face cor. post. East 58.17' fnd. boat spike in mon. box, apparent cor. H-1, T12N-R9E. South 1.62' to centerline joint in E-W pavement. S18°E 13.16' fnd. "+" in center station 1415+00.

Signed by *[Signature]*
Surveyor's Michigan License No. 23503

Date 10-27-97

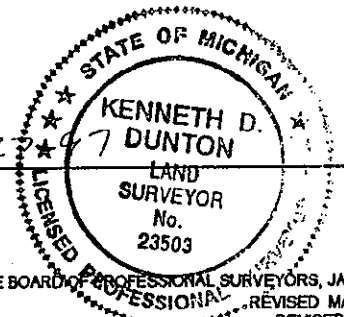

APPROVED
10-27-97
[Signature]

Section A con't from front of form:

Sept. 20, 1984 survey L-546, P-269 by Emery, L.S. #24593, also April 17, 1984 survey L-549, P-1455 by Emery, L.S. #24593. Object and accessories same as L.C.R.C. Page 50. Aug. 2, 1995 survey L-677, P-1325 & 1326 by Field, L.S. #37276. Fnd. 1" rod in mon. box. East 58.16' fnd. boat spike in mon. box, North 10.42' N. edge conc. pave., South 1.66' centerline M-46, S20°E 13.18' center of "+" in Sta. 1415+00.

