

LAND CORNER RECORDATION CERTIFICATE

Filing Requirement of Act 74, Mich. P.A. 1970
1995 REMONUMENTATION PROGRAM

RECEIVED FOR RECORD
LIBER NO. _____ PAGE NO. _____
FILING NO. # 69
Indianfields Twp.
95 OCT 30 AM 9:33
VIRGINIA M. McLANE
TUSCOLA COUNTY
REGISTER OF DEEDS
Register of Deeds Stamp & File Number

For corners in INDIANFIELDS TWP.
TUSCOLA (County) Located In: Corner Code #

1. Public Land Survey	T 12N R 09E	I-1 AMENDED
	T R	MONUMENT
	T R	
	T R	
2. Property Controlling in Section	S T R	
	S T R	
3. Miscellaneous Property in Sec.	S T R	
	S T R	

4. Lot No. _____, Recorded Plat _____
5. Private Claims _____

I, JONATHAN M. FIELD, in a field survey on SEPTEMBER 1 19 95 do hereby certify that under requirements of P.A. 74, Michigan P.A. of 1970, the corner points mentioned in lines 1 and 2 above were in conformance with regulations and rules therefore as required in the current manual of survey instructions of the United States Department of the Interior, Bureau of Land Management or by a decree of a Court of Law and/or that the corner points mentioned in lines 3, 4 and 5 above were in conformance with the rules of the Michigan Board of Land Surveyors or by a Decree of a Court of Law; established, re-established, monumented, re-monumented, recovered, found as expressed below:

NOTE: Not more than 4 corners, all in the same town and range, may be recorded on this certificate.


	A	B	C	D	E	F	G	H	I	J	K	L	M
1													
2	6	5	4	3	2	1							
3													
4	7	8	9	10	11	12							
5													
6	18	17	16	15	14	13							
7													
8	19	20	21	22	23	24							
9													
10	30	29	28	27	26	25							
11													
12	31	32	33	34	35	36							
13													

A. Description of original monument and accessories and/or subsequent restoration:
 1835 GLO; RISDON, D.S.; SET POST; BEECH 14 S72E 27LKS., BEECH 10 S26W 99LKS.
 1955 BLACK, P.S.#3384; UNRECORDED SURVEY SHOWS CORNER; NO OBJECT STATED, NO WITS GIVEN
 1972 ROWE, P.S.#11192; LCRC PG.4; FND 1" PIPE IN MON. BOX; N45E 24.62' MSHD TAG IN P.P. N30W 49.89' MSHD TAG IN P.P., N60E 81.26' SW COR GAS STA., WEST 23.06' SE COR SEC.34 T13N-R9E
 1972 KAY ENG.; KAY, P.S.#14096; SURVEY L.2 PG.154; NO OBJECT STATED; 70.9' NW. COR GAS STA., 47.72' NE COR GAS STATION
 1972 KAY ENG.; KAY, P.S.#14096; SURVEY L.2 PG.153; NO OBJECT STATED; NO WITS GIVEN
 1975 KAY ENG.; KAY, P.S.#14096; UNRECORDED SURVEY; R.R. SPIKE; SAME WITS AS 1972 SURVEY ABOVE
 1975 ROWE ENG.; BECK, P.S.#21559; SURVEY L.455 PG. 375-6; 1" PIPE; SAME WITS AS 1972 LCRC
 1977 KAY ENG.; KAY, P.S.#14096; SURVEY L.484 PG.453; 1" PIPE; SAME WITS AS 1972 LCRC ABOVE
 1978 ROWE ENG.; DUNTON, P.S.#23503; SURVEY L.490 PG.678; 1" PIPE; N45E 20.12' MSHD TAG IN PP. S30W 49.89' MSHD TAG IN P.P., WEST 23.06' SE COR SEC.34 ALMER TWP.
 1983 EMERY, P.S.#24593; SURVEYS L.535 PG.301-3; 1" PIPE IN MON BOX; SAME WITS AS 1972 LCRC
 1984 ROWE ENG.; ROWE, P.S.#11192; SURVEY L.542 PG.373; 1" PIPE; SAME WITS AS 1972 LCRC ABOVE
 1984 EMERY, P.S.#24593; SURVEY L.546 PG.264-5; FND RR SPIKE IN MON BOX; SAME WITS AS 1972 LCRC
 1985 EMERY, P.S.#24593; SURVEY L.556 PG.370; RR SPIKE IN MON BOX; SAME WITS AS 1972 LCRC
 SECTION A. CONTINUED ON BACK

B. Description of corner evidence found and/or method applied in restoring or reestablishing corner:
 1995 ROWE ENG.; FIELD, P.S.#37276; FND 1" ROD IN MON BOX AT C/L-C/L GILFORD ROAD AND ELLINGTON STREET; RECOVERED 1 PREVIOUS WIT INDICATING THAT ROD IS IN SAME POSITION AS 1972 PIPE CITED ABOVE

ACCEPTED FND ROD AS BEST EVIDENCE OF CORNER POSITION

C. Description of monument for corner and accessories established to perpetuate locating the position of the corner:
 I-1 AMENDED MONUMENT DROVE 1" ROD DOWN SET 5/8" ROD W/ STANDARD REMON CAP (ENCASED IN CONG) STAMPED CAP "I 1 A.M. T12N-R9E"
 N60°E, 40.48' FND. P-K NAIL IN S. FACE P. POLE
 N20°E, 85.04' SET NAIL W/REMON TAG IN SE FACE GUY POLE
 S70°W, 81.40' CENTER OF STEEL GUY POLE
 WEST, 23.07' FND R.R. SPIKE IN MON BOX
 S67°E, 26.12' FND. 1/2" ROD W/CAP #37276
 NORTH, 0.18' S. LINE OF T13N-R9E

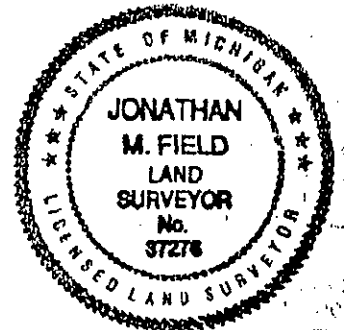

Signed by Jonathan M. Field Date 10-27-95
 Surveyor's Michigan License No. 37276

APPROVED
 10-16-95
 [Signature]

FORM APPROVED BY MICHIGAN STATE BOARD OF LAND SURVEYORS, JAN. 26, 1971
 REVISED MAY 14, 1975
 REVISED JAN., 1983
 ADAPTED FOR WORD PROCESSING MARCH, 1993

DEC 01 1995
 COMMISSION

COPY

SECTION A. (cont.)

1989 DUNTON, P.S.#23503; SURVEYS L.595 PG.80-1; FND 1" PIPE; N45E 40.45' P-K NAIL IN P.P., N25W 55.32' BENCHMARK, N25E 87.83' SW BOLT ON SIGN BASE, WEST 23.06' SE COR. SEC.34 T13N-R9E
 1990 DUNTON, P.S.#23503; LCRC PG.63; FND 1" PIPE; SAME WITS AS 1989 SURVEY ABOVE

