

LAND CORNER RECORDATION CERTIFICATE

Filing Requirement of Act 74, Mich. P.A. 1970

For corners in INDIANFIELDS TWP. 1995 REMONUMENTATION PROGRAM

TUSCOLA (County)	Located In:	Corner Code #
1. Public Land Survey	T 12N R 09E	I-2
	T _____ R _____	_____
	T _____ R _____	_____
	T _____ R _____	_____
2. Property Controlling in Section	S _____ T _____ R _____	_____
	S _____ T _____ R _____	_____
3. Miscellaneous Property in Sec.	S _____ T _____ R _____	_____
	S _____ T _____ R _____	_____

RECEIVED FOR RECORD  
LIBER NO. \_\_\_\_\_ PAGE NO. \_\_\_\_\_  
FILING HO. # 70  
Indianfields Twp  
95 OCT 30 AM 9:33  
VIRGINIA H. MELANCA  
TUSCOLA COUNTY  
REGISTER OF DEEDS  
Register of Deeds Stamp & File Number

4. Lot No. \_\_\_\_\_ Recorded Plat \_\_\_\_\_  
5. Private Claims \_\_\_\_\_

I, JONATHAN M. FIELD, in a field survey on SEPTEMBER 1 19 95 do hereby certify that under requirements of P.A. 74, Michigan P.A. of 1970, the corner points mentioned in lines 1 and 2 above were in conformance with regulations and rules therefore as required in the current manual of survey instructions of the United States Department of the Interior, Bureau of Land Management or by a decree of a Court of Law and/or that the corner points mentioned in lines 3, 4 and 5 above were in conformance with the rules of the Michigan Board of Land Surveyors or by a Decree of a Court of Law; established, re-established, monumented, re-monumented, recovered, found as expressed below:

NOTE: Not more than 4 corners, all in the same town and range, may be recorded on this certificate.

A	B	C	D	E	F	G	H	I	J	K	L	M
1												
2	6	5	4	3	2	1						
3												
4	7	8	9	10	11	12						
5												
6	18	17	16	15	14	13						
7												
8	19	20	21	22	23	24						
9												
10	30	29	28	27	26	25						
11												
12	31	32	33	34	35	36						
13												


A. Description of original monument and accessories and/or subsequent restoration:  
 1835 GLO; RISDON, D.S.; SET POST; BEECH 14 S12W 46LKS, HEMLOCK '8 N12E 23LKS.  
 1956-1967 BLACK, P.S.#3384; SURVEYS; NO OBJECT STATED; NO WITS GIVEN; 1965 SURVEY "SAN MH"  
 1967 CASE SURVEYING; UNRECORDED SURVEY FOR MORELL; NO OBJECT STATED; NO WITS GIVEN  
 1971 ROWE ENG.; ROWE, P.S.#11192; SURVEY L.1 PG.176; P-K NAIL; NW 35.15' TAG IN P.P, NE 83.15' TAG IN P.P, SE 50.23' TAG IN P.P  
 1972 ROWE ENG.; ROWE, P.S.#11192; SURVEY L.1 PG.564-5; NO OBJECT STATED; NO WITS GIVEN  
 1972 ROWE ENG.; ROWE, P.S.#11192; SURVEYS L.2 PG. 5-6, 246-7, L.430 PG.629-30, FND P-K NAIL; SAME WITS AS 1971 SURVEY  
 1972 KAY ENG.; KAY, P.S.#14096; SURVEYS L.2 PG.153-4; NO OBJECT STATED; S60E 122.9' NW COR BLDG, S30W 57.32' NE COR HOUSE, N40W 139.64' SE COR HOUSE  
 1973 ROWE ENG.; ROWE, P.S.#11192; SURVEY L.433 PG.146-7; P-K NAIL; SAME WITS AS 1971 SURVEY  
 1974 ROWE ENG.; ROWE, P.S.#11192; SURVEY L.445 PG.787-8; P-K NAIL; SAME WITS AS 1971 SURVEY  
 1975 ROWE ENG.; BECK, P.S.#21559; SURVEY L.455 PG.375-6; CHIS. + ON MH COVER; SOUTH 86.87' 27" CATALPA, N45W 34.19' T.P., N70E 84.48' T.P.  
 1977 ROWE ENG.; DUNTON, P.S.#23503; SURVEY L.477 PG.855-6; + ON MH COVER; S60E 123.22' NW COR BRICK BLDG, S05E 50.20' MSHD TAG IN T.P, SOUTH 86.87' MSHD TAG IN 28" CATALPA  
 1977 DUNTON, P.S.#23503; LCRC PG.40; FND + ON MH COVER; SAME WITS AS 1977 SURVEY ALSO N45W 34.19' MSHD TAG IN T.P, N70E 84.48' MSHD TAG IN T.P.

SECTION A. CONTINUED ON BACK  
 B. Description of corner evidence found and/or method applied in restoring or reestablishing corner:  
 1995 ROWE ENG.; FIELD, P.S.#37276; FND CHIS. + ON MH COVER (ALIGNMENT MARK MATCH) AT C/L FRANK STREET; RECOVERED 1 PREVIOUS WIT INDICATING THAT + IS IN SAME POSITION AS 1971 P-K NAIL CITED ABOVE

ACCEPTED FND + ON MH AS BEST EVIDENCE OF ORIGINAL CORNER POSITION

C. Description of monument for corner and accessories established to perpetuate locating the position of the corner:

I-2 FND. CHIS. + ON MH COVER (WITNESSES ARE TO CORNER I-2)  
 S01°E, 50.21' FND. NAIL W/MSHD TAG IN E. FACE P.POLE  
 S03°W, 86.48' SET NAIL W/REMON TAG IN W. FACE 36" CATALPA TREE  
 S64°E, 122.74' NW CORNER OF BRICK BLDG.  
 N27°W, 140.80' SE CORNER BRICK BLDG.  
 N42°W, 46.71' FND. DOUBLE HEADED NAIL IN NW FACE P.POLE  
 N60°E, 88.60' TOP CENTER OF HYDRANT  
 EAST, 10.00' SET WITNESS MONUMENT IN MON. BOX ON LINE H-2 THRU I-2 STAMPED CAP "I 2 W.C. T12N R9E"

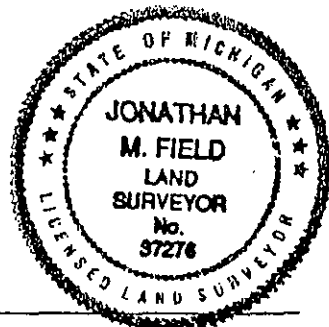

Signed by Jonathan M. Field Date 10-27-95  
 Surveyor's Michigan License No. 37276

APPROVED  
 10-16-95  
*[Signature]*

FORM APPROVED BY MICHIGAN STATE BOARD OF LAND SURVEYORS, JAN. 28, 1971  
 REVISED MAY 14, 1975  
 REVISED JAN, 1983  
 ADAPTED FOR WORD PROCESSING MARCH, 1993

DEC 6 1995

COPY

1978 ROWE ENG.; ROWE, P.S.#11192; SURVEYS L.510 PG.215-6; + ON MH COVER; SAME WITS AS 1977 SURVEY ABOVE  
 1981 EMERY, P.S.#24593; SURVEY L.521 PG.1369-71; FND + IN MH COVER; SAME WITS AS 1977 LCRC ABOVE  
 1981 ROWE ENG.; FOKENS, P.S.#21567; SURVEY L.522 PG.891-3; + ON MH COVER; SAME WITS AS 1977 SURVEY ABOVE  
 1983 EMERY, P.S.#24593; SURVEY L.535 PG.301; + ON MH COVER; SAME WITS AS 1977 LCRC ABOVE  
 1984 EMERY, P.S.#24593; SURVEYS L.540 PG.559-60, L.546 PG.264-5; + ON MH COVER; SAME WITS AS 1977 LCRC ABOVE  
 1985 EMERY, P.S.#24593; SURVEY L.556 PG.370; + ON MH COVER; SAME WITS AS 1977 LCRC ABOVE  
 1987 DUNTON, P.S.#23503; SURVEY L.583 PG.17-8; + ON MH COVER; SAME WITS AS 1977 LCRC ABOVE  
 1988 DUNTON, P.S.#23503; SURVEYS L.588 PG.1274, L.588 PG.1280-1; + ON MH COVER; SOUTH 86.87' 27" CATALPA, N70E 84.48' T.P., N45W 46.70' DBL. HEAD NAIL IN T.P., N65E 93.40' DBL. HEAD NAIL IN T.P.  
 1990 DUNTON, P.S.#23503; LORC PG.63; FND CHIS. + ON MH COVER; SAME WITS AS 1989 SURVEY ABOVE  
 1991 ROWE ENG.; OWENS, P.S.#20709; SURVEY L.614 PG.1413-20; FND + ON MH LID; S05E 50.20' MSHD TAG IN P.P., N60E 93.39' MSHD TAG IN P.P., N45W 46.68' MSHD TAG IN P.P., SOUTH 86.87' MSHD TAG W. FACE 36" CATALPA  
 1993 ROWE ENG.; FIELD, P.S.#37276; SURVEY L.647 PG.1164-5; FND + ON MH COVER; S05E 50.20' MSHD TAG IN P.P., N60E 93.39' MSHD TAG IN P.P., N45W 46.65' MSHD TAG IN P.P., SOUTH 86.87' FND NAIL W. FACE 36" TREE  
 1993 ROWE ENG.; FIELD, P.S.#37276; SURVEY L.669 PG.806; FND + ON MH COVER; S01E 50.21' MSHD TAG IN P.P., S03W 86.88' CTR 36" CATALPA, S64E 122.74' NW COR BRICK BLDG, N70E 93.34' MSHD TAG IN P.POLE, N27W 140.80' SE COR BRICK BLDG, N42W 46.71' MSHD TAG IN P.P.

