

LAND CORNER RECORDATION CERTIFICATE

Filing Requirement of Act 74, Mich. P.A. 1970
1995 REMONUMENTATION PROGRAM

For corners in INDIANFIELDS TWP.
TUSCOLA (County) Located In: Corner Code #

1. Public Land Survey	T	12N	R	09E	I-3
	T		R		
	T		R		
	T		R		
2. Property Controlling in Section	S	T	R		
	S	T	R		
3. Miscellaneous Property in Sec.	S	T	R		
	S	T	R		

RECEIVED FOR RECORD
LIBERNON. PAGE NO. _____
FILING NO. # 71
95 OCT 30 AM 9:33
Indianfields Twp
VIRGINIA H. McCLAREN
TUSCOLA COUNTY
REGISTER OF DEEDS

Register of Deeds Stamp & File Number

4. Lot No. _____, Recorded Plat _____
5. Private Claims _____

I, JONATHAN M. FIELD, in a field survey on SEPTEMBER 1 19 95 do hereby certify that under requirements of P.A. 74, Michigan P.A. of 1970, the corner points mentioned in lines 1 and 2 above were in conformance with regulations and rules therefore as required in the current manual of survey instructions of the United States Department of the Interior, Bureau of Land Management or by a decree of a Court of Law and/or that the corner points mentioned in lines 3, 4 and 5 above were in conformance with the rules of the Michigan Board of Land Surveyors or by a Decree of a Court of Law, established, re-established, monumented, re-monumented, recovered, found as expressed below:

NOTE: Not more than 4 corners, all in the same town and range, may be recorded on this certificate.

	A	B	C	D	E	F	G	H	I	J	K	L	M
1													
2	6	5	4	3	2	1							
3													
4	7	8	9	10	11	12							
5													
6	18	17	16	15	14	13							
7													
8	19	20	21	22	23	24							
9													
10	30	29	28	27	26	25							
11													
12	31	32	33	34	35	36							
13													

A. Description of original monument and accessories and/or subsequent restoration:

- 1835 GLO; RISDON, D.S.; SET POST; HEMLOCK 12 S23E 15LKS, HEMLOCK 22 N58W 30LKS.
- 1964 CASE, P.S.#7431; UNRECORDED SURVEY; MON BOX; NO WITS GIVEN
- 1972 ROWE ENG.; ROWE, P.S.#11192; SURVEY L.1 PG.176; 3/4" PIPE IN MON BOX; N20W 58.10' G.POST S65W 69.94' T.POST, S35E 73.82' CHIS + ON PROJECT MARKER
- 1972 ROWE ENG.; ROWE, P.S.#11192; SURVEY L.1 PG.564-5; NO OBJECT STATED; NO WITS GIVEN
- 1974 ROWE ENG.; ROWE, P.S.#11192; SURVEY L.450 PG.603; MON BOX; S60W 69.2' SPIKE IN P.P, S35E 73.75' NE CORNER R.O.W. MARKER, N60E 53.8' S. LEG OF STOP SIGN
- 1981 EMERY, P.S.#24593; SURVEY L.521 PG.1369-71; FND 3/4" IRON IN MON. BOX; N30E 84.8' SE COR WINGWALL, S35E 74.0' TOP CTR CONC POST, S50W 69.9' MSHD TAG IN T.P, N60W 60.7 R/W POST
- 1981 EMERY, P.S.#24593; LCRC PG.44; FND 3/4" ROD IN MON. BOX; SAME WITS AS 1981 SURVEY
- 1984 ROWE ENG.; ROWE, P.S.#11192; SURVEY L.555 PG.1260-1; 3/4" PIPE IN MON BOX; 1972 WITS
- 1987 DUNTON, P.S.#23503; SURVEY L.578 PG.82-3; NO OBJECT STATED; NO WITS GIVEN
- 1987 DUNTON, P.S.#23503; SURVEY L.583 PG.17-8; NO OBJECT STATED; NO WITS GIVEN


B. Description of corner evidence found and/or method applied in restoring or reestablishing corner:

- 1995 ROWE ENG.; FIELD, P.S.#37276; FND 3/4" PIPE IN MON BOX AT C/L-C/L M-24 AND GUN CLUB ROAD; RECOVERED 1 PREVIOUS WIT INDICATING THAT PIPE IS IN SAME POSITION AS 1972 PIPE CITED ABOVE

ACCEPTED FND PIPE AS BEST EVIDENCE OF ORIGINAL CORNER POSITION

C. Description of monument for corner and accessories established to perpetuate locating the position of the corner:

- I-3 SET 5/8" ROD IN FND PIPE W/ STANDARD REMON CAP (ENCASED IN CONC) IN MON BOX
- S55°W, 66.81' SET NAIL W/REMON TAG IN P.POLE STAMPED CAP "I 1 T12N-R9E"
- S54°W, 75.14' SET NAIL W/REMON TAG IN P.POLE
- N76°W, 122.08' SET NAIL W/REMON TAG IN P.POLE
- N27°W, 120.72' SET NAIL W/REMON TAG IN P.POLE
- N72°E, 107.41' SET NAIL W/REMON TAG IN P.POLE
- S36°E, 74.06' TOP CENTER OF CONC. PROJECT MARKER POST

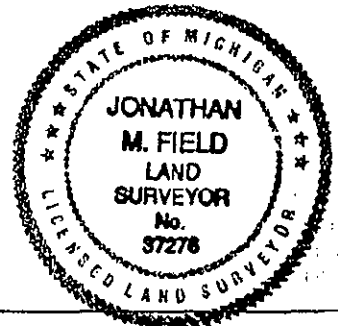

Signed by Jonathan M. Field Date 10-27-95
Surveyor's Michigan License No. 37276

FORM APPROVED BY MICHIGAN STATE BOARD OF LAND SURVEYORS, JAN. 28, 1971
REVISED MAY 14, 1975
REVISED JAN, 1983
ADAPTED FOR WORD PROCESSING MARCH, 1993


SURVEY & RECORDS

APPROVED

10-16-95




DEC 6 1995

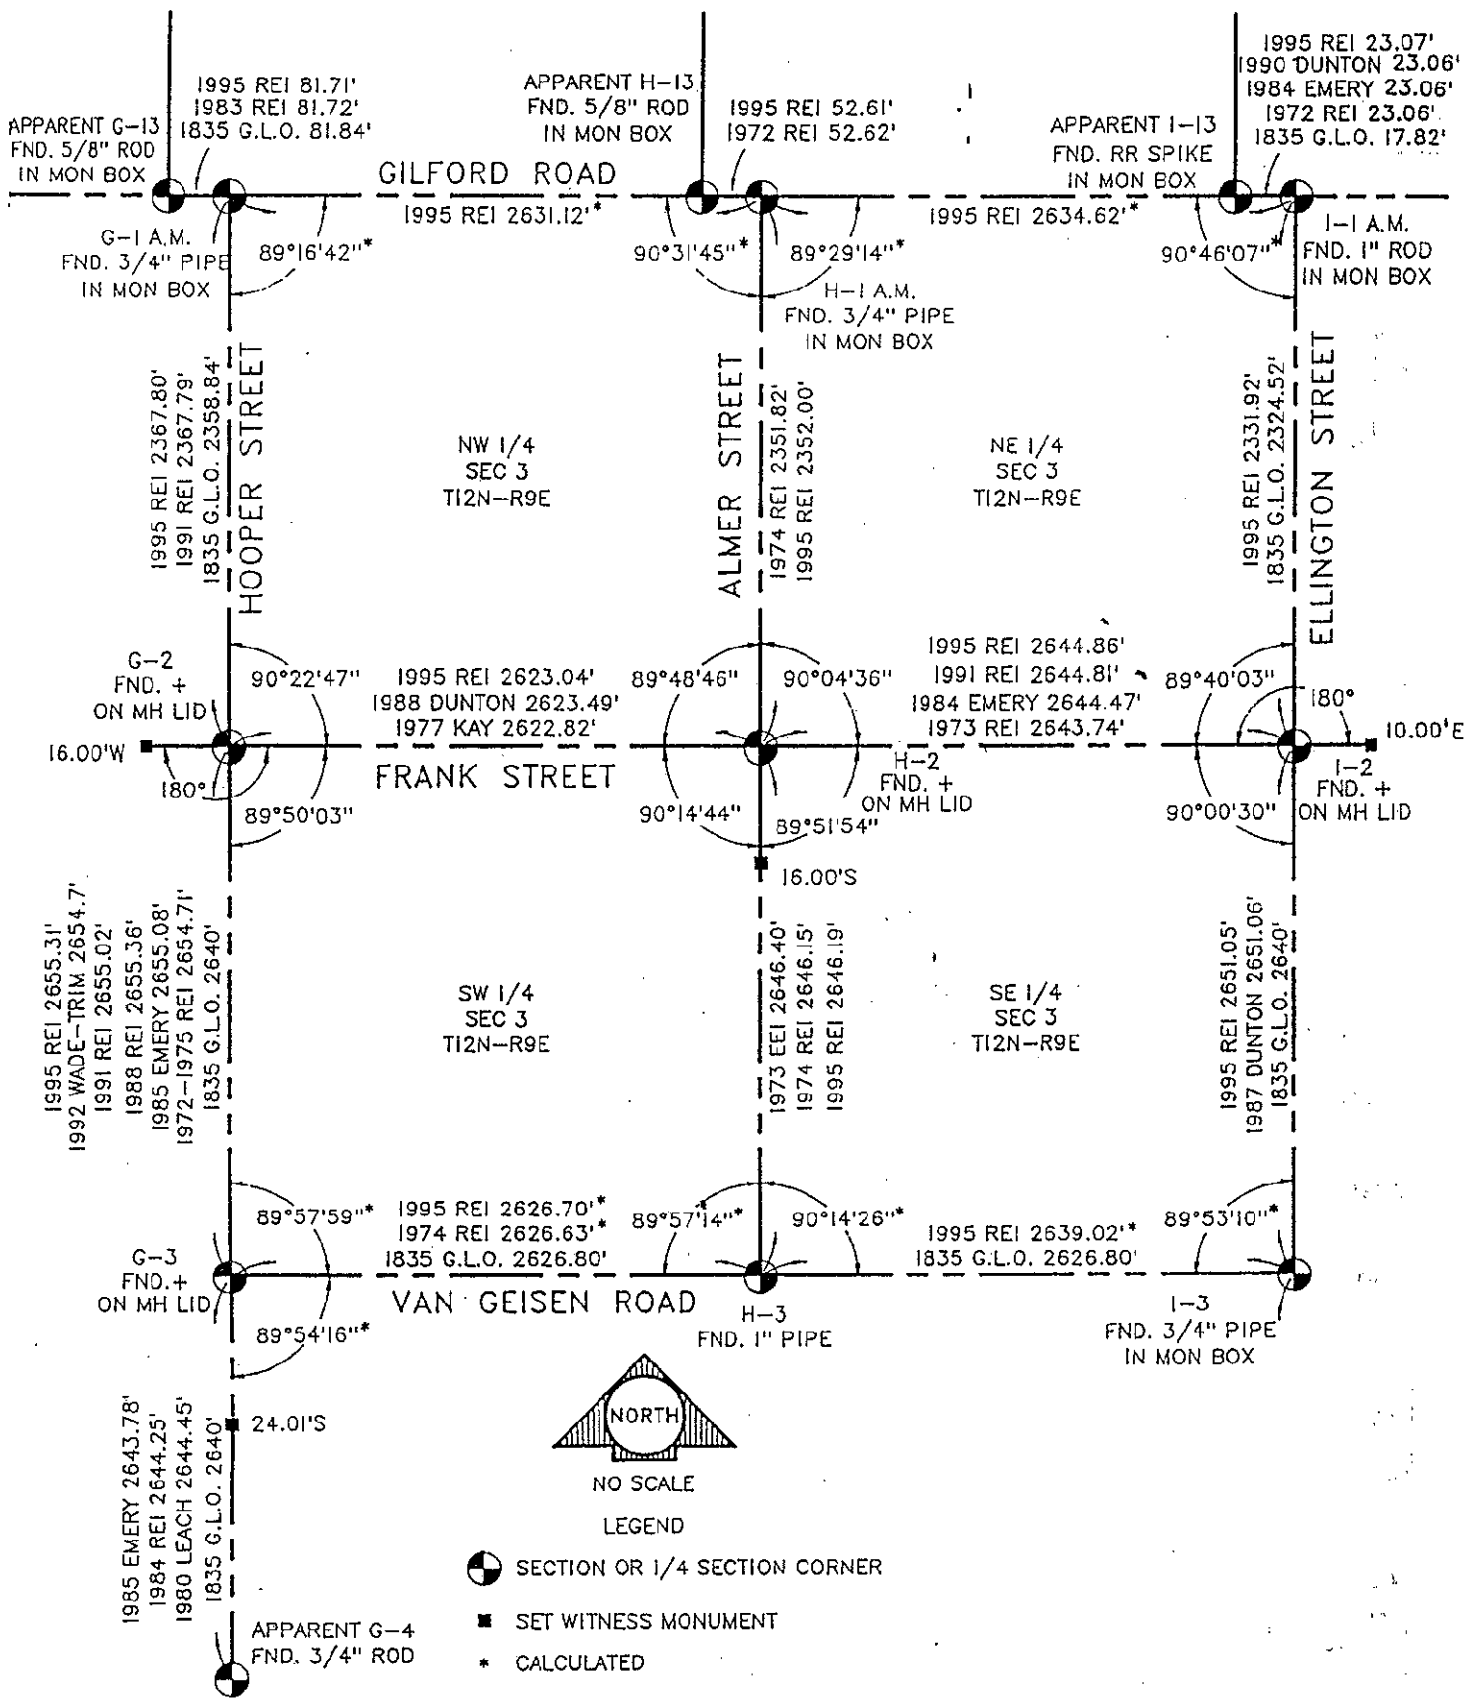COPY



NO SCALE

LEGEND

-  SECTION OR 1/4 SECTION CORNER
-  SET WITNESS MONUMENT
-  CALCULATED