

MAR 05 1998

SECTION

1997 REMONUMENTATION PROGRAM
LAND CORNER RECORDATION CERTIFICATE
Filing Requirement of Act 74, Mich. P.A. 1970

For corners in Indianfields Twp.

Tuscola (County)	Located In:	Corner Code #
1. Public Land Survey	T <u>12N</u> R <u>09E</u>	<u>J-13</u>
	T <u> </u> R <u> </u>	<u> </u>
	T <u> </u> R <u> </u>	<u> </u>
	T <u> </u> R <u> </u>	<u> </u>
2. Property Controlling in Section	S <u> </u> T <u> </u> R <u> </u>	<u> </u>
	S <u> </u> T <u> </u> R <u> </u>	<u> </u>
3. Miscellaneous Property in Sec.	S <u> </u> T <u> </u> R <u> </u>	<u> </u>
	S <u> </u> T <u> </u> R <u> </u>	<u> </u>

RECEIVED FOR RECORD
LIBER NO. _____ PAGE NO. 89
FILE NO. _____
INDIANFIELDS TOWNSHIP
OCT NOV -5 PM 4:02

George W. Breen

TUSCOLA COUNTY
REGISTER OF DEEDS

COPY

Register of Deeds Stamp & File Number

4. Lot No. _____, Recorded Plat _____
5. Private Claims _____

I, Kenneth D. Dunton, in a field survey on Sept. 9, 1997 do hereby state that under requirements of P.A. 74, Michigan P.A. of 1970, the corner points mentioned in lines 1 and 2 above were in conformance with regulations and rules therefore as required in the current manual of survey instructions of the United States Department of the Interior, Bureau of Land Management or by a decree of a Court of Law and/or that the corner points mentioned in lines 3, 4 and 5 above were in conformance with the rules of the Michigan Board of Land Surveyors or by a Decree of a Court of Law; established, re-established, monumented, recovered, found as expressed below:

NOTE: Not more than 2 corners, all in the same town and range, may be recorded on this certificate.

	A	B	C	D	E	F	G	H	I	J	K	L	M
1													
2	6		5		4		3		2		1		
3													
4	7		8		9		10		11		12		
5													
6	10		17		16		15		14		13		
7													
8	19		20		21		22		23		24		
9													
10	30		29		28		27		26		25		
11													
12	31		32		33		34		35		36		
13													

A. Description of original monument and accessories and/or subsequent restoration:

March 19, 1834 Hervey Parke, D.S. Set quarter section post, Beech 10" N78°W 35 links, Beech 8" N79°E 30 1/2 links. Sept. 5, 1968 M.S.H.D. witness card, R. Fosdick, Survey Chief. 1" iron, due North 16.40' to SE cor. of conc. R.O.W. marker, N20°E 39.50' to 6" Maple, S40°W 52.20' to lt. edge of metal sta. 36+95 (pavement joint). Oct. 30, 1980 survey L-511, P-878 & 879 by Fokens, L.S. #21567. 1/2" pipe. N30°E 36.68' 6" Maple, S70°W 74.04' 17" Beech, S05°E 59.52' T & P pole. Oct. 5, 1984 surveys L-547, P-1446 through 1457 by Fluharty, L.S. #18223. Fnd. spike. 12" Maple N28°E 39.21', 12" Red Pine N44°W 99.10', face of conc. R/W marker N40°E 16.30'. Aug. 7, 1995 survey L-684, P-1430 & 1431 by Erickson, L.S. #29245.
(Section A con't on back of form)

B. Description of corner evidence found and/or method applied in restoring or reestablishing corner:

Found 1" iron rod in place and two accessories that indicate that the corner found is in the same position as the 1968 M.S.H.D. witness card. Accepted 1" iron rod as the best evidence of the original corner.


C. Description of monument for corner and accessories established to perpetuate locating the position of the corner:

Removed 1" iron rod and placed concrete monument with standard brass cap. Stamped cap J-13, T12N-R9E.
N08°W 17.20' fnd. nail & tag #29245 in E. face t. pole stub.
N01°30'W 16.45' chiseled "+" atop conc. R.O.W. marker.
North 44.18' chiseled "+" atop conc. R.O.W. marker.
N23°E 39.61' fnd. spike in E. face 15" Maple.
South 58.80' centerline joint of E-W conc. pavement.
East 43.65' fnd. 1" iron rod at apparent cor. J-1, T11N-R9E.

Signed by *Kenneth D. Dunton*
Surveyor's Michigan License No. 23503

Date 10-27

APPROVED
10-27-97
JBE
RJB
JMT

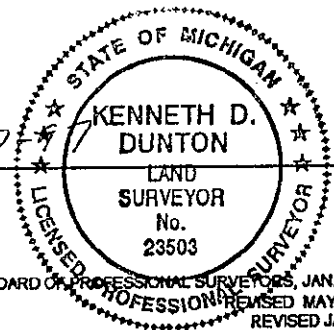

Section A con't from front of form:

Fnd. 1" iron pipe. N05°E 16.46' top center of R/W marker, N80°W 78.64' fnd. N & T S. side post, N53°W 87.25' fnd. SE cor. iron gate post, N02°W 17.69' fnd. N & T E. side 6" post.

