

SURVEY & REMONUMENTATION

MAR 05 1998

RECEIVED FOR RECORD
LIBER NO. _____ PAGE NO. 90


1997 REMONUMENTATION PROGRAM
LAND CORNER RECORDATION CERTIFICATE
Filing Requirement of Act 74, Mich. P.A. 1970

INDIANFIELDS TOWNSHIP
97 NOV -5 PM 4:02

SECTION

For corners in Indianfields Twp.

<u>Tuscola</u> (County)	Located In:	Corner Code #
1. Public Land Survey	T <u>12N</u> R <u>09E</u>	<u>K-13</u>
	T _____ R _____	_____
	T _____ R _____	_____
	T _____ R _____	_____
2. Property Controlling in Section	S _____ T _____ R _____	_____
	S _____ T _____ R _____	_____
3. Miscellaneous Property in Sec.	S _____ T _____ R _____	_____
	S _____ T _____ R _____	_____

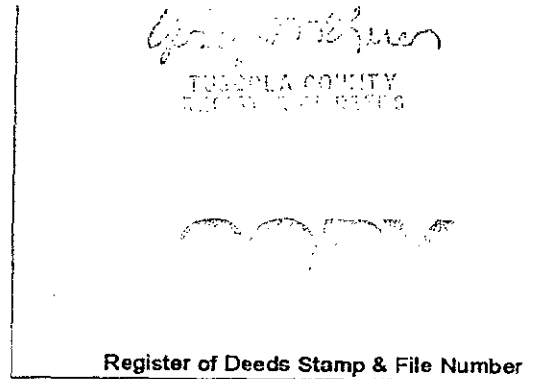

4. Lot No. _____, Recorded Plat _____
5. Private Claims _____

I, Kenneth D. Dunton, in a field survey on Sept. 6, 1997 do hereby state that under requirements of P.A. 74, Michigan P.A. of 1970, the corner points mentioned in lines 1 and 2 above were in conformance with regulations and rules therefore as required in the current manual of survey instructions of the United States Department of the Interior, Bureau of Land Management or by a decree of a Court of Law and /or that the corner points mentioned in lines 3, 4 and 5 above were in conformance with the rules of the Michigan Board of Land Surveyors or by a Decree of a Court of Law; established, re-established, monumented, recovered, found as expressed below:

	A	B	C	D	E	F	G	H	I	J	K	L	M
1													
2	6		5		4		3		2		1		
3													
4	7		8		9		10		11		12		
5													
6	18		17		16		15		14		13		
7													
8	19		20		21		22		23		24		
9													
10	30		29		28		27		26		25		
11													
12	31		32		33		34		35		36		
13													

NOTE: Not more than 2 corners, all in the same town and range, may be recorded on this certificate.

A. Description of original monument and accessories and/or subsequent restoration:

March 19, 1834 Hervey Parke, D.S. Set post corner Sections 35 & 36. Beech 12" N59°W 9 links, Hemlock 10" N76°E 30 links. Feb.-Apr. 1963 M.S.H.D. witness card, H.G. McManus, Survey Chief. 3/4" Pipe. South 53.49' 14" Cherry, S35°W 61.45' p.p., N50°W 63.77' p.p. Sept. 5, 1968 M.S.H.D. witness card, R. Fosdick, Survey Chief. 1" iron. N20°E 36.30' to power pole, S20°E 85.50' to Sta. 62+95.48, N45°W 72.00' to power pole. Aug. 7, 1995 survey L-684, P-1430 & 1431 by Erickson, L.S. #29245. Fnd. 1" iron pipe. N41°E 36.35' fnd. M.S.H.D. N & T in SE side p. pole, S86°E 23.16' 3/4" iron pipe, N45°W 72.27' fnd. M.S.H.D. N & T, NE side p. pole, N05°E 107.83' SE cor. of garage.

B. Description of corner evidence found and/or method applied in restoring or reestablishing corner:


Found 1" pipe in place and two accessories that indicate the corner found is in the same position as the 1968 M.S.H.D. witness card. Accepted 1" pipe as the best evidence of the original corner.

C. Description of monument for corner and accessories established to perpetuate locating the position of the corner:

Removed 1" pipe and placed concrete monument with standard brass cap stamped K-13, T12N-R9E. N50°W 72.27' fnd. M.S.H.D. tag & spike in NE face p. pole. N30°E 32.14' set T.C. Remon. tag & spike in SE face new p. pole. East 23.13' fnd. 1" pipe at apparent cor. K-1, T11N-R9E. S16°E 85.59' fnd. 5/8" iron rod in mon. box. (Sta. 62+95.48).

Signed by [Signature]
Surveyor's Michigan License No. 23503

Date 10-27-97

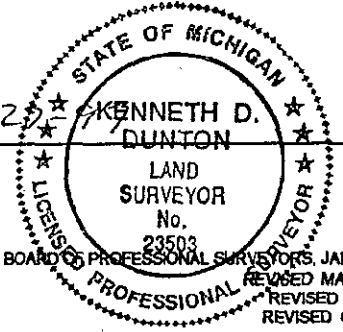

APPROVED
10-27-97
[Signatures]

