REMONUMENTATION

MAR 0 5 1998


REU.L.	PAGE NO. 9/
LIBER ITO	J-ACE 110

\sim \sim	~~
SECT	IC IN

1997 REMONUMENTATION PROGRAM FIRIDS TOWNSHIP.

AND CORNER RECORDATION CERTIFICATE? (1911 - 5	Pii 4: 02
Filing Requirement of Act 74, Mich. P.A. 1970	

Filing Requirement of Act 74, Mich. P.A. 19 For corners in Indianfields Twp.	
Tuscola Located In: Corner Code #	Gos Migran
(County)	THOUGH A COMPTY ELECTRIC CONTROL OF
1. Public Land Survey T12N R 09E	GOPY
in Section S T R	
Property in Sec. S TR	Register of Deeds Stamp & File Number
4. Lot No, Recorded Plat	A B C D E F G H I J K L
	2 5 4 4 - 3 - 2 - 1 - 1
Kenneth D. Dunton, in a field survey on Sept. 6, 1997 do hereby state that under	3 4 7 8 9 10 11 12
requirements of P.A. 74, Michigan P.A. of 1970, the corner points mentioned in lines 1 and 2 above were in conformance with regulations and rules therefore as required in the current manual of survey instructions of the	5
United States Department of the Interior, Bureau of Land Management or by a decree of a Court of Law and for that the corner points mentioned in lines 3, 4 and 5 above were in conformance with the rules of the Michigan	6 18 17 16 15 14 13
Board of Land Surveyors or by a Decree of a Court of Law; established, re-established, monumented, recovered, found as expressed below:	8192021222324
NOTE: Not more than 2 comers, all in the same town and range, may be recorded	9
on this certificate.	10 30 29 28 27 26 25
	11
Description of original monument and accessories and/or subsequent restoration:	13
B. Description of comer evidence found and/or method applied in restoring or reestablishing confound 1" iron pipe in place. No previous accessories remain becards to corners K-13 & M-13, T12N-R9E check relative well. (ner: y distances shown on witness
1" iron pipe found as the best evidence of the orginal corner.	
C. Description of monument for corner and accessories established to perpetuate locating the per	d brace can stamped L-13
Removed 1" iron pipe and placed concrete monument with standar T12N-R9E. S75°W 68.78' set T. C. Remon. tag & spike in 4" x 4" wood post S89°E 144.44' set T. C. Remon. tag & spike in S. face new p. p East 4.10' fnd. 1" pipe at apparent corner L-1, T11N-R9E. S03°E 68.85' set 1/2" iron rod in N. shoulder M-46. South 90.7' E-W centerline conc. pavement, M-46.	, tele. ped. support.
	GIATE OF A
Signed by Date Surveyor's Michigan License No 23503	KENNETH D. * KENNETH D. * DUNTON LAND SURVEYOR SURVEYOR SURVEYOR
APPROVED APE	No. 23503
10-27-97 1283 FORM APPROVED BY MICH	IGAN STATE BOARD OF PROFESSIONAL SURVEYORS, AN. 28, 20, ESSIONESSED MAY 14 MEVISED JAN
JM.T.	REVISED OCT.

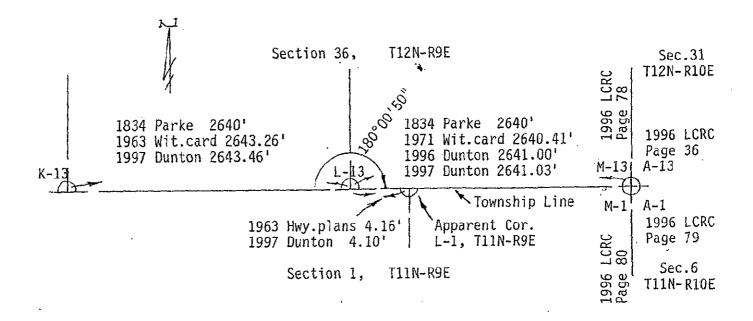

re i

1: "

·

•