MAR 0 5 1998

SECTION


1997 REMONUMENTATION PROGRAM

RECEIVED FOR RECORD __PAGE NO.#43

| LIDE | n reo. | PA(|
|-------|--------|---------|
| 511 7 | 210 | |

LAND CORNER RECORDATION CERTIFICATE WELLS TOWNSHITP
Filing Requirement of Act 74, Mich. P.A. 1970 97 101 -5 PM lt. 03

| For corners in Wells Township | | | |
|---|---|--|--|
| Tuscola Located In: Corner Code # | Gray Morran | | |
| (County) 1. Public Land Survey T12NR 10E F-13 | TUSONA COUNTY BELLETO, DETOS | | |
| TR | | | |
| TR TR | | | |
| 2. Property Controlling S T R in Section S T R | | | |
| 3. Miscellaneous S T R Property in Sec. S T R | | | |
| Property in Sec. | Register of Deeds Stamp & File Number | | |
| 4. Lot No, Recorded Plat | ABCDEFGHIJKLM | | |
| 5. Private Claims | 2 6 5 4 3 2 1 | | |
| Varnath D. Duntan | 3 - 1 - 1 - 1 - 1 - 1 - 1 - 1 - 1 - 1 - | | |
| Kenneth D. Dunton, in a field survey on Sept. 21, 1997 do hereby state that under 4 7 8 9 10 11 requirements of P.A. 74, Michigan P.A. of 1970, the comer points mentioned in lines 1 and 2 above were in | | | |
| conformance with regulations and rules therefore as required in the current manual of survey instructions of United States Department of the Interior, Bureau of Land Management or by a decree of a Court of Law and that the corner points mentioned in lines 3, 4 and 5 above were in conformance with the rules of the Michig | /or 6 18 1 1 1 1 1 1 1 1 1 1 1 1 1 1 1 1 1 | | |
| Board of Land Surveyors or by a Decree of a Court of Law; established, re-established, monument recovered, found as expressed below: | ed, 7 20 21 22 23 24 | | |
| NOTE: Not more than 2 corners, all in the same town and range, may be recorded | 9 | | |
| on this certificate. | 10 30 29 27 26 25 | | |
| | 12 31 32 34 35 36 | | |
| Description of original monument and accessories and/or subsequent restoration: | 13 | | |
| Jan. 1834 Hervey Parke, D.S. Set quarter section post. He 6" N60°E 36 links. Sept. 6, 1968 M.S.H.D. witness card, R. Due North 50.20' fence post, N20°E 55.10' tele. pole, due Somarker. Feb. 26, 1974 survey L-438, P-722, 723 & 724 by Kay North 50.19' nail in cor. post, N30°E 54.88' nail in t. pole mon. June 16, 1979 survey L-509, P-1328 and Oct. 10, 1980 st.S. #23503. No object or accessories mentioned. B. Description of corner evidence found and/or method applied in restoring or reestablishing Found 1" pipe in place and one accessory that indicates the | Fosdick, Survey Chief, 1" pipe. buth 5.70' to N. edge conc. R.O.W. y, L.S. #14096. Fnd. 3/4" pipe. , South 5.80' center of hwy. R/W survey L-497, P-1252 by Dunton, gcomer: corner found is in the same | | |
| position as the 1968 witness card. Accepted 1" pipe as the corner. | pest evidence of the original | | |
| | | | |
| | | | |
| | | | |
| | · · · · · · · · · · · · · · · · · · · | | |
| C. Description of monument for corner and accessories established to perpetuate locating tr | | | |
| Removed 1" pipe and placed concrete monument with standard I South 5.70' North face of concrete R/W marker. South 81.00' E-W centerline concrete pavement M-46. S80°W 3.50' fnd. dbl. head nail in S. face fence post. S85°E 10.80' fnd. dbl. head nail in S. face fence post. East 33.60' fnd. 1" pipe at apparent corner F-1, T11N-R10E. | brass cap stamped F-13, 112N-KIUE. | | |
| | SE OF MICHIER | | |
| 1 ANAD | KEMMETH D | | |
| Signed by Date_ | DUNTON TAND | | |
| Surveyor's Michigan License No. 23503 | SURVEYOR No. | | |
| | MICHIGAN STATE BOARD OF PROFESSIONAL SURVEYORS, JAN. 28, 1971 | | |
| 10-27-97 RB | AND OFESSION REVISED JAN., 1983 REVISED OCT., 1995 | | |

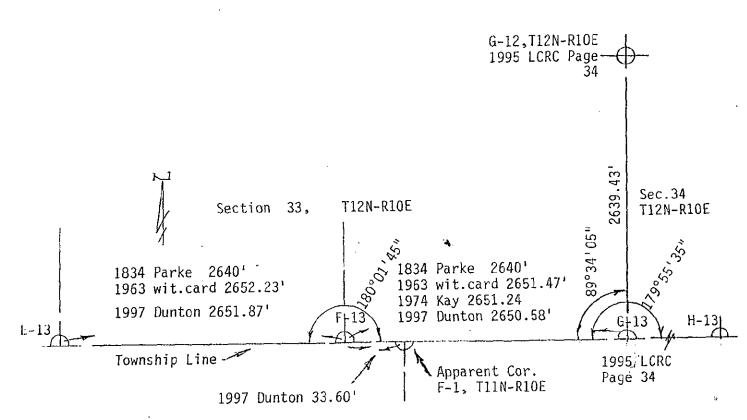

Section 4, T11N-R10E

} . .

W.Z7 ;

......

₩...

÷. ---