

SURVEY & REMONUMENTATION

MAR 02 1999

**1998 REMONUMENTATION PROGRAM
LAND CORNER RECORDATION CERTIFICATE
Filing Requirement of Act 74, Mich. P.A. 1970**

SECTION

For corners in Wells Township

<u>Tuscola</u> (County)	Located In:	Corner Code #
1. Public Land Survey	T12N R10E	M-8
	T ___ R ___	_____
	T ___ R ___	_____
	T ___ R ___	_____
2. Property Controlling in Section	S ___ T ___ R ___	_____
	S ___ T ___ R ___	_____
3. Miscellaneous Property in Sec.	S ___ T ___ R ___	_____
	S ___ T ___ R ___	_____

RECEIVED FOR RECORD
LIBER NO. _____ PAGE NO. _____
FILE NO. #05
WELLS TWP
98 DEC 10 PM 4:13
TUSCOLA COUNTY
REGISTER OF DEEDS
Dunton
Register of Deeds Stamp & File Number

4. Lot No. _____, Recorded Plat _____
5. Private Claims _____

I, Kenneth D. Dunton in a field survey on April 12 1998 do hereby state that under requirements of P.A. 74, Michigan P.A. of 1970, the corner points mentioned in lines 1 and 2 above were in conformance with regulations and rules therefore as required in the current manual of survey instructions of the United States Department of the Interior, Bureau of Land Management or by a decree of a Court of Law and /or that the corner points mentioned in lines 3, 4 and 5 above were in conformance with the rules of the Michigan Board of Land Surveyors or by a Decree of a Court of Law; established, re-established, monumented, recovered, found as expressed below:

NOTE: Not more than 2 corners, all in the same town and range, may be recorded on this certificate.

A	B	C	D	E	F	G	H	I	J	K	L	M
1												
2	6	5	4	3	2	1						
3												
4	7	8	9	10	11	12						
5												
6	18	17	16	15	14	13						
7												
8	19	20	21	22	23	24						
9												
10	30	29	28	27	26	25						
11												
12	31	32	33	34	35	36						
13												

A. Description of original monument and accessories and/or subsequent restoration:

G.L.O. Notes Nov. 17, 1834 by H. Parke, D.S., set 1/4 section post, Tamarac 9", N48°W .27, Tamarac 11" S8°W .38.

B. Description of corner evidence found and/or method applied in restoring or reestablishing corner:

Found 1/2" iron rod and pointed stone below rod. Accepted found 1/2" rod & stone as the best evidence of the original corner.

Corner M-8, T12N-R10E is common with Corner A-8, T12N-R11E.


C. Description of monument for corner and accessories established to perpetuate locating the position of the corner:


Removed rod & stone and perpetuated with standard monument stamped M-8, T12N-R10E.
Placed stones and pieces of iron around base of monument.
N33°E 46.64' fnd. P.K. nail in SE face P. Pole, set T.C. Remon. tag & spike above P.K.
S20°W 48.84' Southwest corner of Southwest wingwall of bridge.
S67°W 28.70' West corner of Northwest wingwall of bridge.
S55°E 18.92' East corner of Northeast wingwall of bridge.
S13°E 45.67' Southeast corner of Southeast wingwall of bridge.
North 8.5' ± physical centerline of E-W gravel road.
West 5.5' ± physical centerline of N-S gravel road.

Signed by [Signature]
Surveyor's Michigan License No. 23503

Date 11-25-98

APPROVED
11-25-98
[Signatures]

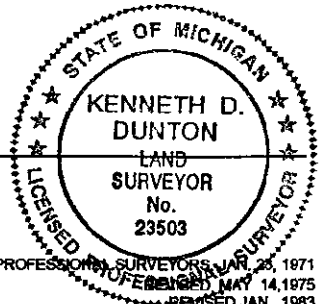

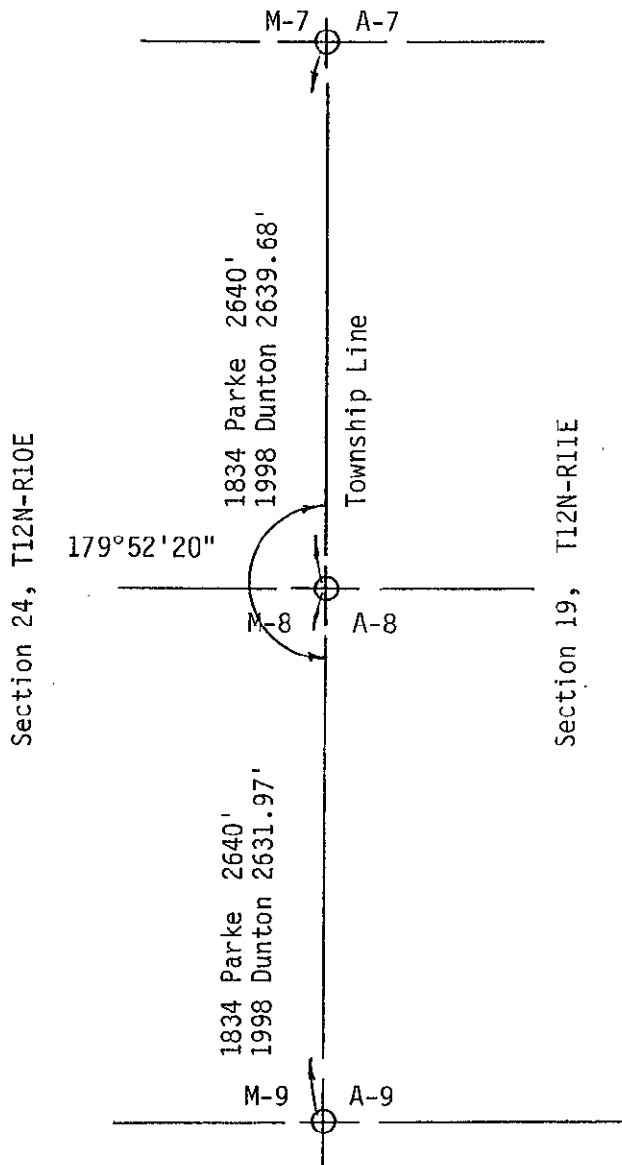

SURVEY &
REMONUMENTATION

MAR 02 1999

SECTION

55