

MAR 02 1999

1998 REMONUMENTATION PROGRAM
LAND CORNER RECORDATION CERTIFICATE
 Filing Requirement of Act 74, Mich. P.A. 1970

SECTION

For corners in Kingston Township

<u>Tuscola</u> (County)	Located In:	Corner Code #
1. Public Land Survey	T <u>12</u> N R <u>11</u> E	<u>A-8</u>
	T ___ R ___	_____
	T ___ R ___	_____
	T ___ R ___	_____
2. Property Controlling in Section	S ___ T ___ R ___	_____
	S ___ T ___ R ___	_____
3. Miscellaneous Property in Sec.	S ___ T ___ R ___	_____
	S ___ T ___ R ___	_____

RECEIVED FOR RECORD
 LIBER NO. _____ PAGE NO. _____
 FILE NO. #76
KINGSTON TWP
 98 DEC 10 PM 4:14
Joseph J. Duntorin
 TUSCOLA COUNTY
 REGISTER OF DEEDS

Register of Deeds Stamp & File Number

4. Lot No. _____, Recorded Plat _____
 5. Private Claims _____

Law and/or that the corner points mentioned in lines 3, 4 and 5 above were in conformance with the rules of the Michigan Board of Land Surveyors or by a Decree of a Court of Law, established, re-established, monumented, recovered, found as expressed below:

NOTE: Not more than 2 corners, all in the same town and range, may be recorded on this certificate.

1	A	B	C	D	E	F	G	H	I	J	K	L	M
2		6		5		4		3		2		1	
3													
4		7		8		9		10		11		12	
5													
6		18		17		16		15		14		13	
7													
8		19		20		21		22		23		24	
9													
10		30		29		28		27		26		25	
11													
12		31		32		33		34		35		36	
13													

A. Description of original monument and accessories and/or subsequent restoration:

G.L.O. Notes Nov. 17, 1834 by H. Parke, D.S., set 1/4 section post, Tamarac 9", N48°W .27, Tamarac 11" S8°W .38.

B. Description of corner evidence found and/or method applied in restoring or reestablishing corner:

Found 1/2" iron rod and pointed stone below rod. Accepted found 1/2" rod & stone as the best evidence of the original corner.

Corner A-8, T12N-R11E is common with Corner M-8, T12N-R10E.


C. Description of monument for corner and accessories established to perpetuate locating the position of the corner:


Removed rod & stone and perpetuated with standard monument stamped M-8, T12N-R10E.
 Placed stones and pieces of iron around base of monument.
 N33°E 46.64' fnd. P.K. nail in SE face P. Pole, set T.C. Remon. tag & spike above P.K.
 S20°W 48.84' Southwest corner of Southwest wingwall of bridge.
 S67°W 28.70' West corner of Northwest wingwall of bridge.
 S55°E 18.92' East corner of Northeast wingwall of bridge.
 S13°E 45.67' Southeast corner of Southeast wingwall of bridge.
 North 8.5' ± physical centerline of E-W gravel road.
 West 5.5' ± physical centerline of N-S gravel road.

 Surveyor's Michigan License No. 23503

Date 12-2-98

APPROVED
12-2-98
A.P.E.
R.B.S.
J.M.T.

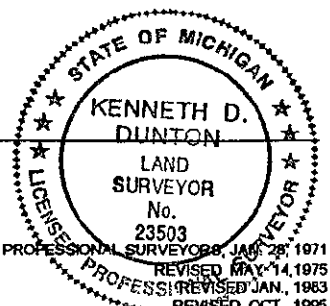

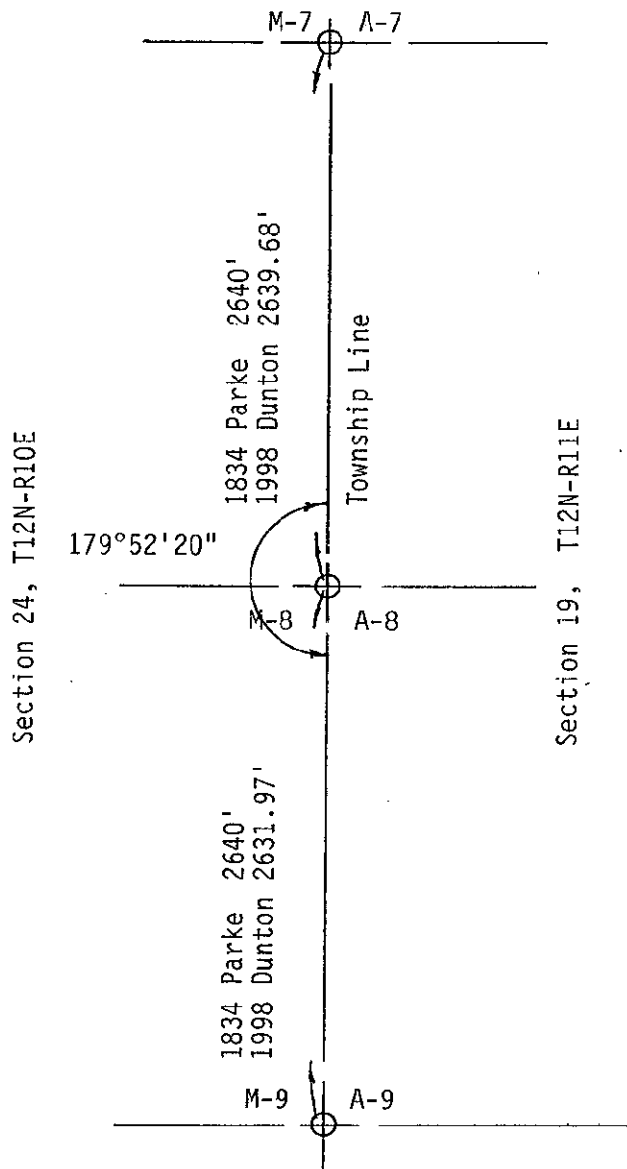

SURVEY &
REMONUMENTATION

MAR 02 1999

SECTION