

SURVEY & REMONUMENTATION

MAR 05 1998

RECEIVED FOR RECORD
LIBER NO. _____ PAGE NO. _____
FILE NO. #61

SECTION

1997 REMONUMENTATION PROGRAM 97 NOV 12 PM 3:47
LAND CORNER RECORDATION CERTIFICATE
Filing Requirement of Act 74, Mich. P.A. 1970

For corners in Kingston Township

Tuscola
(County)

Located In:

Corner Code #

- | | | |
|------------------------------------|--|-------------|
| 1. Public Land Survey | T <u>12</u> N <u>R11E</u> | <u>B-13</u> |
| | T <u> </u> R <u> </u> | <u> </u> |
| | T <u> </u> R <u> </u> | <u> </u> |
| | T <u> </u> R <u> </u> | <u> </u> |
| 2. Property Controlling in Section | S <u> </u> T <u> </u> R <u> </u> | <u> </u> |
| | S <u> </u> T <u> </u> R <u> </u> | <u> </u> |
| 3. Miscellaneous Property in Sec. | S <u> </u> T <u> </u> R <u> </u> | <u> </u> |
| | S <u> </u> T <u> </u> R <u> </u> | <u> </u> |

[Signature]
TUSCOLA COUNTY
REGISTER OF DEEDS

COPY

Register of Deeds Stamp & File Number

4. Lot No. _____, Recorded Plat _____
5. Private Claims _____

I, Kenneth D. Dunton, in a field survey on Sept. 28, 1997 do hereby state that under requirements of P.A. 74, Michigan P.A. of 1970, the corner points mentioned in lines 1 and 2 above were in conformance with regulations and rules therefore as required in the current manual of survey instructions of the United States Department of the Interior, Bureau of Land Management or by a decree of a Court of Law and /or that the corner points mentioned in lines 3, 4 and 5 above were in conformance with the rules of the Michigan Board of Land Surveyors or by a Decree of a Court of Law, established, re-established, monumented, recovered, found as expressed below:

NOTE: Not more than 2 corners, all in the same town and range, may be recorded on this certificate.

1	A	B	C	D	E	F	G	H	I	J	K	L	M
2		6		5		4		3		2		1	
3													
4		7		8		9		10		11		12	
5													
6		18		17		16		15		14		13	
7													
8		19		20		21		22		23		24	
9													
10		30		29		28		27		26		25	
11													
12		31		32		33		34		35		36	
13													

A. Description of original monument and accessories and/or subsequent restoration:

March 18, 1834 Hervey Parke, D.S. Set quarter section post. Beech 12" N55 1/2°E 57 links, Beech 10" N81°W 24 1/2 links. July 1963 M.S.H.D. witness card, H. G. McManus, Survey Chief, 1" pipe. S20°E 34.75' 18" Maple, S18°W 35.77' 24" Maple, N45°E 88.61' p. pole. Aug. 22, 1985 survey L-553, P-365 by Emery, L.S. #24593. Found pipe in monument box. North 75.4' face of conc. R/W marker, N55°E 67.6' West end corr. metal pipe, N80°E 100.28' nail in mailbox post, West 87.0' ctr. of mon. box at P.C. March 28, 1990 survey L-615, P-692 by Gravlin, L.S. #23510. No mention of object or accessories. July 31, 1992 unrecorded survey Job No. 1286-92 by Dunton, L.S. #23503. Fnd. 1" pipe in monument box. Accessories same as survey L-553, P-365.

B. Description of corner evidence found and/or method applied in restoring or reestablishing corner:


Found 1" pipe in monument box and two accessories that indicate the corner found is in the same position as the 1985 survey L-553, P-365. Accepted 1" pipe as the best evidence of the original corner.

C. Description of monument for corner and accessories established to perpetuate locating the position of the corner:

Placed standard brass cap over 1" pipe found in monument box. Stamped cap B-13, T12N-R11E. Encased cap in concrete in monument box. North 75.41' S. face concrete R/W marker. West 86.97' fnd. 1/2" rod in mon. box at centerline P.C. S07°W 11.84' rt. edge concrete pave. at sta. 457+07 (pave. joint). N10°W 12.27' lt. edge concrete pave. at sta. 457+07 (pave. joint). South 0.20' E-W centerline conc. pavement M-46.

Signed by [Signature]
Surveyor's Michigan License No. 23503

Date 11-10-97

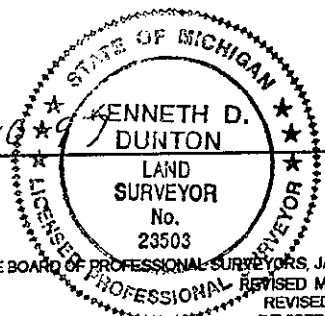

APPROVED
11-10-97
[Signatures]

