

SURVEY & REMONUMENTATION

MAR 05 1998

1997 REMONUMENTATION PROGRAM

LAND CORNER RECORDATION CERTIFICATE
Filing Requirement of Act 74, Mich. P.A. 1970

SECTION

For corners in Kingston Township

<u>Tuscola</u> (County)	Located In:	Corner Code #
1. Public Land Survey	<u>T12N R11E</u>	<u>D-13</u>
	T <u> </u> R <u> </u>	<u> </u>
	T <u> </u> R <u> </u>	<u> </u>
	T <u> </u> R <u> </u>	<u> </u>
2. Property Controlling in Section	S <u> </u> T <u> </u> R <u> </u>	<u> </u>
	S <u> </u> T <u> </u> R <u> </u>	<u> </u>
3. Miscellaneous Property in Sec.	S <u> </u> T <u> </u> R <u> </u>	<u> </u>
	S <u> </u> T <u> </u> R <u> </u>	<u> </u>

4. Lot No. _____, Recorded Plat _____
5. Private Claims _____

I, Kenneth D. Dunton, in a field survey on Sept. 28, 1997 do hereby state that under requirements of P.A. 74, Michigan P.A. of 1970, the corner points mentioned in lines 1 and 2 above were in conformance with regulations and rules therefore as required in the current manual of survey instructions of the United States Department of the Interior, Bureau of Land Management or by a decree of a Court of Law and/or that the corner points mentioned in lines 3, 4 and 5 above were in conformance with the rules of the Michigan Board of Land Surveyors or by a Decree of a Court of Law; established, re-established, monumented, recovered, found as expressed below:

NOTE: Not more than 2 corners, all in the same town and range, may be recorded on this certificate.

	A	B	C	D	E	F	G	H	I	J	K	L	M
1													
2		6		5		4		3		2		1	
3													
4		7		8		9		10		11		12	
5													
6		16		17		16		15		14		13	
7													
8		19		20		21		22		23		24	
9													
10		30		29		28		27		26		25	
11													
12		31		32		33		34		35		36	
13													

A. Description of original monument and accessories and/or subsequent restoration:

March 18, 1834 Hervey Parke, D.S. Set quarter section post. Hemlock 10" N47°W 27 links, Hemlock 12" N54 1/2°E 25 1/2 links. July 1963 M.S.H.D. witness card, H. G. McManus, survey chief, chiseled "x" in pavement. S15°E 44.99' 24" Apple, N30°E 35.20' 17" Box Elder, N55°E 47.09' 16" Box Elder. Oct. 1971 L.C.R.C. Page 5 by Rowe, L.S. #11192. Found 1" pipe in monument box. North 3.5' centerline hwy. M-46, westerly 2647.31' SW cor. Sec. 32, West 268.5' N 1/4 cor. Sec. 5 Koylton Twp. Oct. 10, 1971 survey L-1, P-239 & 240 by Rowe, L.S. #11192. 1" pipe in mon. box. North 3.5' centerline hwy. M-46, West 268.5' ± N 1/4 cor. Sec. 5 Koylton Township, S05°E 17.5' mailbox post. Feb. 2, 1972 survey L-1, P-366 & 367 by Rowe, L.S. #11192. Section A con't on back of form.

B. Description of corner evidence found and/or method applied in restoring or reestablishing corner:


Found 1" pipe in monument box and two accessories that indicate the corner found is in the same position as the 1971 L.C.R.C. page 5. Accepted 1" pipe as the best evidence of the original corner.

C. Description of monument for corner and accessories established to perpetuate locating the position of the corner:

Placed standard brass cap over 1" pipe found in monument box. Stamped cap D-13, T12N-R11E. Encased cap in concrete in monument box. North 3.45' E-W centerline conc. pavement M-46. N60°E 32.90' lt. edge conc. pavement at sta. 510+37 (pave. joint). S75°E 30.25' rt. edge conc. pavement at sta. 510+37 (pave. joint). S55°W 56.60' center of manhole cover. West 268.60' fnd. 1" pipe in mon. box at apparent cor. D-1, T11N-R11E.

Signed by *[Signature]*
Surveyor's Michigan License No. 23503

Date 11-10-97

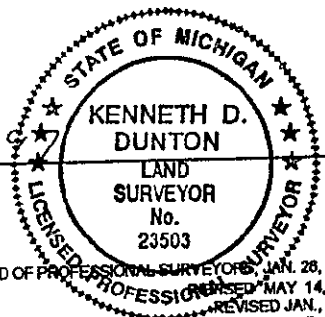

APPROVED
11-10-97
[Signatures]

RECEIVED FOR RECORD
LIBER NO. _____ PAGE NO. _____
FILE NO. #63
97 NOV 12 PM 3:4
TUSCOLA COUNTY
REGISTERED SURVEYOR
COPY
Register of Deeds Stamp & File Number

Section A con't from front of form:

Object and accessories same as survey L-1, P-239 & 240. July 6, 1994 survey L-667, P-983 & 984 by Field, L.S. #37276. Fnd. 1" pipe in mon. box. North 3.45' centerline joint in conc. pavement, S89°W 268.48' fnd. 1" pipe in mon. box, West 2647.69' SW cor. Sec. 32, T12N-R11E; North 2630.66' center 1/4 cor. Sec. 32, T12N-R11E. Sept. 8, 1994 survey L-670, P-1288 by Gravlin, L.S. #23510. Fnd. 1" pipe in mon. box. North 5.5' centerline hwy. M-46, S05°E 17.5' mailbox post, West 268.5' ± N. 1/4 cor. Sec. 5, T11N-R11E.

