
MAR 0 5 1998

1997 REMONUMENTATION PROGRAM   LAND CORNER RECORDATION CERTIFFiling Requirement of Act 74, Mich. P.A.	FICATE S S S S S S S S S S S S S S S S S S S
4. Lot No, Recorded Plat	r 6 18 17 16 15 14 13
A. Description of original monument and accessories and/or subsequent restoration:  March 18, 1834 Hervey Parke, D.S. Set post corner Sections 34 links, Beech 8" N56°E 50 links. Aug. 1, 1963 M.S.H.D. witness #3165. Found 1" pipe buried 1'. N35°W 69.40 t.p., N45°E ₹2.5 Elm. Sept. 9, 1968 M.S.H.D. witness card, R. Fosdick, Survey N45°E 97.30' p. pole, S60°W 24.50' rt. edge metal sta. 88+11.7 edge metal sta. 88+11.7 (pave. joint). July 22, 1971 Survey L (mon. box) South 43.05' 2" pipe road sign post, N70°W 100.72' 1987 Survey L-578, P-070 & 071 by Dunton, L.S. #23503. No obj	% 35. Hemlock 10" N61 1/2°W 38 card by Donald C. Pyle, R.L.S. 2' p.p., N60°E 77.05' 24" twin Chief. 1" pipe in monument box. (pave. joint), N60°W 26.30' lt. –1, P-139 by Kay, L.S. #14096. 2" pipe road sign post. Sept. 14 ect or accessories mentioned.
Found 1" pipe in monument box and three accessories that indicates ame position as the 1968 witness card. Accepted 1" pipe in monof the original corner.  C. Description of monument for corner and accessories established to perpetuate locating the populaced standard brass cap over 1" pipe found in monument box. Encased cap in concrete in monument box.	onument box as the best evidence
West 50.12' fnd. 1/2" rod in mon. box at apparent centerline P. N30°E 97.67' fnd. M.S.H.D. tag in east face p. pole. N60°W 26.20' left edge conc. pavement @ sta. 88+11.7 (pave join S65°W 24.50' rt. edge conc. pavement @ sta. 88+11.7 (pave. join North 2.0' E-W centerline conc. pavement M-46.  Signed by	t).  t).  t).  KENNETH D.  LAND SURVEYOR No. 23503

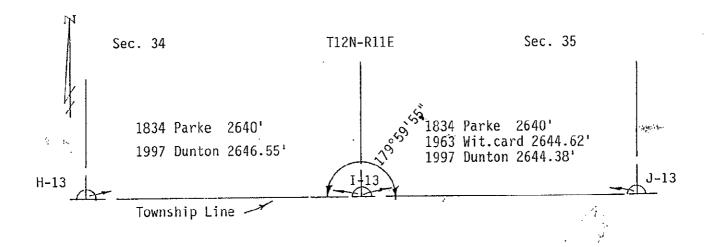

Sec. 3

T11N-R11E

Sec. 2

| | . .