

COPY

DEC 07 1994

COMMISSION

1994 REMONUMENTATION PROGRAM  
LAND CORNER RECORDATION CERTIFICATE

Filing Requirement of Act 74, Mich. P.A. 1970

For corners in KINGSTON TOWNSHIP

TUSCOLA (County)		Located In:	Corner Code -#
1. Public Land Survey	T 12N. R 11E		M-1
	T _____ R _____		_____
	T _____ R _____		_____
	T _____ R _____		_____
2. Property Controlling in Section	S _____ T _____ R _____		_____
	S _____ T _____ R _____		_____
3. Miscellaneous Property in Sec.	S _____ T _____ R _____		_____
	S _____ T _____ R _____		_____

RECEIVED FOR RECORD  
LIBER NO. \_\_\_\_\_ PAGE NO. \_\_\_\_\_  
FILING NO. #45  
Kingston Twp.  
94 NOV -9 PM 2:18  
VIRGINIA M. McLAREN  
TUSCOLA COUNTY  
REGISTER OF DEEDS  
Register of Deeds Stamp & File Number

- 4. Lot No. \_\_\_\_\_, Recorded Plat \_\_\_\_\_
- 5. Private Claims \_\_\_\_\_

	A	B	C	D	E	F	G	H	I	J	K	L
2	6	5	4	3	2	1						
3												
4	7	8	9	10	11	12						
5												
6	18	17	16	15	14	13						
7												
8	19	20	21	22	23	24						
9												
10	30	29	28	27	26	25						
11												
12	31	32	33	34	35	36						
13												

I, Lionel Roy Emery, in a field survey on July 15, 1994, do hereby certify that under requirements of P.A. 74, Michigan P.A. of 1970, the corner points mentioned in lines 1 and 2 above were in conformance with regulations and rules therefore as required in the current manual of survey instructions of the United States Department of the Interior, Bureau of Land Management or by a decree of a Court of Law and/or that the corner points mentioned in lines 3, 4 and 5 above were in conformance with the rules of the Michigan Board of Land Surveyors or by a Decree of a Court of Law; established, re-established, monumented, re-monumented, recovered, found as expressed below:


NOTE: Not more than 4 corners, all in the same town and range, may be recorded on this certificate.

- A. Description of original monument and accessories and/or subsequent restoration:
- 1834 (Government Land Office Notes) Harvey Parke, D.S. -Township corner established- Hemlock 24 S64W 20; Hemlock 10 N23½E 5
  - 1889 (Resurvey of Evergreen Twp., T13N-R12E, Sanilac County) F.F. Rogers, Surveyor -Set Vitriified Stone (corner) 3 inches in diameter and 3 feet in the Earth- gives no accessories, but says set from old stake planted by J.A. Teskey from bearing trees and checked by Rogers
  - 1974 (Survey -Liber 3 of Surveys, pages 116 and 117, Sanilac County) Irvin E. Choep, P.S. 6504. Survey is of Section 31, T13N-R12E and shows Southwest corner of Section 31. Gives no object marking corner and no accessories.

B. Description of corner evidence found and/or method applied in restoring or reestablishing corner:  
Found ½" diameter reinforcing rod together with accessories marked with nails and flagging. Reinforcing rod found at approximate centerline/ centerline intersection of Gravel Road North & South with Gravel Road East. Dug in gravel and subsoil--found no further markings.

Accepted found reinforcing rod as marking original corner.

- C. Description of monument for corner and accessories established to perpetuate locating the position of the corner:
- N54°E, 51.41'-T.C. Re-mon. tag in Northwest face of 14" Poplar (also nail & flagging S.W. face)
  - S68°E, 84.69'-T.C. Re-mon. tag in Southwest face of 8" Basswood
  - S42°E, 41.05'-T.C. Re-mon. tag in West leg of upright Steel Vehicle Frame
  - N75°W, 29.78'-T.C. Re-mon. tag above found nail in South face of telephone pedestal support post

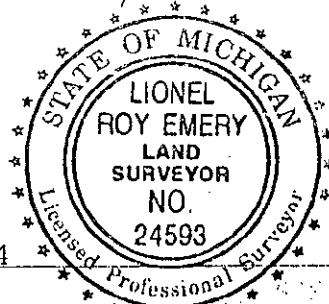

Signed by Lionel Roy Emery  
Surveyor's Michigan License No. 24593

Date Oct. 20, 1994

APPROVED  
10-20-94

COPY

TUSCOLA COUNTY  
NOVESTA TWP.  
T13N-R11E



NO SCALE

TUSCOLA COUNTY  
KINGSTON TWP.  
T12N-R11E

N.E. 1/4 OF SECTION 1

S.E. 1/4 OF SECTION 36

PARKE 1834 2620.20 FT.  
(AS PER GOV'T. LAND OFFICE NOTES)  
PARKE 1834 2755.50 FT.  
(AS PER GOV'T. LAND OFFICE PLAT)  
EMERY 1994 2759.40 FT.

PARKE 1834 2640 FT.  
ROGERS 1889 2640.35 FT.  
CHOPE 1974 5278 FT. (SECTION)  
EMERY 1994 2638.80 FT.

179°34'09"

ROAD

DOWNINGTON ROAD

LAMTON

SANILAC COUNTY  
EVERGREEN TWP.  
T13N-R12E

SANILAC COUNTY  
LAMOTTE TWP.  
T12N-R12E

COPY