

COPY

DEC 07 1994

COMMISSIONER

1994 REMONUMENTATION PROGRAM
LAND CORNER RECORDATION CERTIFICATE
Filing Requirement of Act 74, Mich. P.A. 1970

For corners in KINGSTON TOWNSHIP

<u>TUSCOLA</u> (County)	Located In:	Corner Code -#
1. Public Land Survey	T 12N. R 11E	M-5
	T _____ R _____	_____
	T _____ R _____	_____
	T _____ R _____	_____
2. Property Controlling in Section	S _____ T _____ R _____	_____
	S _____ T _____ R _____	_____
3. Miscellaneous Property in Sec.	S _____ T _____ R _____	_____
	S _____ T _____ R _____	_____

4. Lot No. _____, Recorded Plat _____
5. Private Claims _____

RECEIVED FOR RECORD
LIBER NO. _____ PAGE NO. _____
FILING NO. #49
94 NOV -9 PM 2:18
Kingston
VIRGINIA H. MCLAREN
TUSCOLA COUNTY
REGISTER OF DEEDS

Register of Deeds Stamp & File Number

A	B	C	D	E	F	G	H	I	J	K	L
2	6	5	4	3	2						
3											
4	7	8	9	10	11						
5											
6	18	17	16	15	14						
7											
8	19	20	21	22	23	24					
9											
10	30	29	28	27	26	25					
11											
12	31	32	33	34	35	36					
13											


i. Lionel Roy Emery in a field survey on July 14, 1994
do hereby certify that under requirements of P.A. 74, Michigan P.A. of 1970, the corner points mentioned in lines 1 and 2 above were in conformance with regulations and rules therefore as required in the current manual of survey instructions of the United States Department of the Interior, Bureau of Land Management or by a decree of a Court of Law and/or that the corner points mentioned in lines 3, 4 and 5 above were in conformance with the rules of the Michigan Board of Land Surveyors or by a Decree of a Court of Law, established, re-established, monumented, re-monumented, recovered, found as expressed below:

NOTE: Not more than 4 corners, all in the same town and range, may be recorded on this certificate.

A. Description of original monument and accessories and/or subsequent restoration:
1834 (Gov't. Land Office Notes) Harvey Parke, D.S. -Set post corner Sections 12 & 13- Pine 18 N14W 9; Cedar 10 S32½W 74
1976 (Survey -Liber 3 of Surveys, Page 412, Sanilac County) Irvin E. Chope, P.S. 6504 -found ½' bar- Southeasterly* 35.20' F.P; Southerly* 20.63' F.P (Note: "*" indicates approximate bearing as per sketch shown on Survey Certificate by Chope)

B. Description of corner evidence found and/or method applied in restoring or reestablishing corner:
Found ½" reinforcing ^{v rod} driven into approximately 30" stub of post
Accepted reinforcing rod as marking original corner.

C. Description of monument for corner and accessories established to perpetuate locating the position of the corner:
Removed reinforcing rod and post stub and replaced with Standard Tuscola County Concrete Monument with 2" Brass Cap stamped M5 T12N/R11E
East, 21.62'-Set ½" diameter reinforcing rod
S04°W, 44.76'-T.C. Re-mon. tag in West face of 3" Cherry
S80°W, 90.06'-T.C. Re-mon. tag in South face of 14" Willow
N16°W, 39.41'-T.C. Re-mon. tag in East face of 3" Elm
North, 1.0'-"Survey Marker" witness post

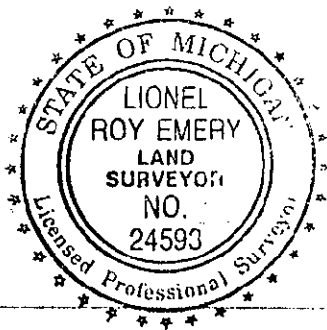

Signed by Lionel Roy Emery Date Oct. 20, 1994
Surveyor's Michigan License No. 24593

APPROVED
10-20-94

COPY

