

REMONUMENTATION

COPY

DEC 07 1994

1994 REMONUMENTATION PROGRAM
LAND CORNER RECORDATION CERTIFICATE

Filing Requirement of Act 74, Mich. P.A. 1970

For corners in KINGSTON TOWNSHIP

RECEIVED FOR RECORD
LIBER NO. _____ PAGE NO. _____
FILING NO. 455
Kingston Twp.
94 NOV -9 PM 2:18
VIRGINIA H. McIAREN
TUSCOLA COUNTY
REGISTER OF DEEDS

Register of Deeds Stamp & File Number

<u>TUSCOLA</u> (County)	Located In:	Corner Code #/
1. Public Land Survey	T 12N. R 11E.	M11
	T _____ R _____	_____
	T _____ R _____	_____
	T _____ R _____	_____
2. Property Controlling in Section	S _____ T _____ R _____	_____
	S _____ T _____ R _____	_____
3. Miscellaneous Property in Sec.	S _____ T _____ R _____	_____
	S _____ T _____ R _____	_____

- 4. Lot No _____, Recorded Plat _____
- 5. Private Claims _____

A	B	C	D	E	F	G	H	I	J	K
2	6	5		4		3		2		
3										
4	7	8		9		10		11		
5										
6	18	17		16		15		14		
7										
8	19	20		21		22		23		
9										
10	30	29		28		27		26		
11										
12	31	32		33		34		35		

I, Lionel Roy Emery, in a field survey on July 6, 1994, do hereby certify that under requirements of P.A. 74, Michigan P.A. of 1970, the corner points mentioned in lines 1 and 2 above were in conformance with regulations and rules therefore as required in the current manual of survey instructions of the United States Department of the Interior, Bureau of Land Management or by a decree of a Court of Law and/or that the corner points mentioned in lines 3, 4 and 5 above were in conformance with the rules of the Michigan Board of Land Surveyors or by a Decree of a Court of Law, established, re-established, monumented, re-monumented, recovered, found as expressed below:

NOTE: Not more than 4 corners, all in the same town and range, may be recorded on this certificate.

- A. Description of original monument and accessories and/or subsequent restoration:
- 1834 (Gov't. Land Office Notes) Harvey Parke, D.S. -Set post corner Secs. 25 & 36- Hemlock 1 S71½W 9½; Beech 9 N10½W 12
 - 1978 (Survey, Liber 491, Page 986, Tuscola County) David T. Rowe, P.S. 11192 -Set 3/4" pipe cap 11192- N55°W 66.10' RLS 11192 tag in PP: N65°W 67.32' RLS tag 11192 in Maple; S70°W 57.91' RLS tag 11192 in TP; East 18.25' RLS tag 11192 in TP
 - 1978 (Land Corner Recordation Certificate) David T. Rowe, P.S. 11192 -Set 3/4" pipe w/cap RLS 11192 at intersection of lines between East ¼ Cor's Sec 25 & 36, T12N-R11E and survey line of R.J. Black- Accessories same as above Survey


B. Description of corner evidence found and/or method applied in restoring or reestablishing corner:

Found 3/4" inside diameter by 30" long pipe.
Accepted pipe as marking original corner.

- C. Description of monument for corner and accessories established to perpetuate locating the position of the corner:
- Removed Pipe and Replaced with Standard Tuscola County Concrete Monument with 2" Brass Cap stamped M11 T12N/R11E
 - East, 18.10'-T.C. Re-mon. tag above 11192 tag in South face of Telephone pole
 - S55°W, 41.05'-Northeast face of Road name sign post
 - S75°W, 58.00'-T.C. Re-mon. tag above 11192 tag in Northwest face of Telephone Pole
 - N45°W, 66.12'-T.C. Re-mon. tag above 11192 tag in Southwest face of Power Pole
 - West, 6'+/- -Centerline of Gravel

Signed by Lionel Roy Emery Date Oct. 10, 1994
Surveyor's Michigan License No. 24593

APPROVED
10-10-94

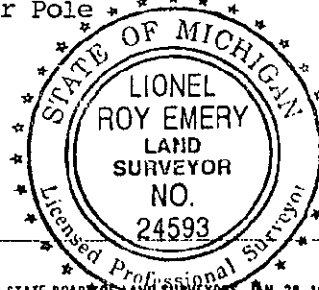

COPY

