

DEC 07 1994

COPY

COMMISSION

1994 REMONUMENTATION PROGRAM
LAND CORNER RECORDATION CERTIFICATE

Filing Requirement of Act 74, Mich. P.A. 1970

For corners in KINGSTON TOWNSHIP

RECEIVED FOR RECORD
LIBER NO. _____ PAGE NO. _____
FILING NO. # 56
KINGSTON TWP.
94 NOV -9 PM 2: 18
VIRGINIA H. MCCLAREN
TUSCOLA COUNTY
REGISTER OF DEEDS

TUSCOLA
(County)

Located In:

Corner Code ##

1. Public Land Survey	T 12N R 11E	M-12
	T _____ R _____	_____
	T _____ R _____	_____
	T _____ R _____	_____
2. Property Controlling in Section	S _____ T _____ R _____	_____
	S _____ T _____ R _____	_____
3. Miscellaneous Property in Sec.	S _____ T _____ R _____	_____
	S _____ T _____ R _____	_____

Register of Deeds Stamp & File Number

- 4. Lot No. _____, Recorded Plat _____
- 5. Private Claims _____

A	B	C	D	E	F	G	H	I	J	K	L
2	6	5	4	3	2						
3											
4	7	8	9	10	11						
5											
6	18	17	16	15	14						
7											
8	19	20	21	22	23						
9											
10	30	29	28	27	26						
11											
12	31	32	33	34	35						
13											

I, Lionel Roy Emery, in a field survey on July 6, 1994, do hereby certify that under requirements of P.A. 74, Michigan P.A. of 1970, the corner points mentioned in lines 1 and 2 above were in conformance with regulations and rules therefore as required in the current manual of survey instructions of the United States Department of the Interior, Bureau of Land Management or by a decree of a Court of Law and/or that the corner points mentioned in lines 3, 4 and 5 above were in conformance with the rules of the Michigan Board of Land Surveyors or by a Decree of a Court of Law; established, re-established, monumented, re-monumented, recovered, found as expressed below:

NOTE: Not more than 4 corners, all in the same town and range, may be recorded on this certificate.

A. Description of original monument and accessories and/or subsequent restoration:

- 1834 (Gov't. Land Office Notes) HARVEY Parke, D.S. -Set qr. Sec. post- Lynn N41W 23½; Beech 9 S62W 14
- 1963 (Michigan State Highway Department witness card) Donald C. Pyle, P.S. 3165 -Set 3/4" Iron N17°E 63.82' 14" Ash; S22°W 37.25' 15" Tw. Ash; N86°W 35.92' 24" Tri. Elm
- 1973 (Survey-Liber 2 of Surveys, page 76, Tuscola County) David T. Rowe, P.S. 11192 -Fnd. 1" I Bar- N25°W 52.58' Nail in 6" Ash; S65°W 17.78' Nail in 6" Ash; N40°W 32.61' Road Sign post
- 1976 (Survey -Liber 3 of Surveys, pages 389 and 390, Sanilac County) Robert G. Kay, P.S. 14096 -Fd. 1" iron bar- N25°W 52.58' Nail 6" Ash; S65°W 17.78' Nail 6" Ash; N40°W 32.61' Rd sign
- 1978 (Land Corner Recordation Certificate) David T. Rowe, P.S. 11192 -Fnd 1" sq. Iron- S60°E 32 Rd. sign post; N15°E 106.75' RLS 11192 tag in 8" Ash; N45°W 33.00' Rd. sign post (See over

B. Description of corner evidence found and/or method applied in restoring or reestablishing corner:

Found 1" diameter by 18" long reinforcing rod. All accessories from Surveys shown in Section A. (above) were obliterated. Position of found object was accepted as marking original corner subsequent to retracing Getz', Kay's and Pyle's surveys.


C. Description of monument for corner and accessories established to perpetuate locating the position of the corner:

- Removed 1" reinforcing rod and replaced with Standard Tuscola County Concrete Monument with 2" Brass Cap stamped M12 T12N/R11E
- N25°E, 50.29' -Set ½" reinforcing rod
- S45°E, 46.64' -Found 3/8" diameter smooth iron bar
- S65°W, 31.76' -T.C. Re-mon. tag in Northwest face of 8" Aspen
- N20°W, 61.66' -T.C. Re-mon. tag in Southwest face of 6" Ash in clump of Ash

Signed by Lionel Roy Emery Date Oct. 10, 1994

Surveyor's Michigan License No. 24593

APPROVED
10-10-94

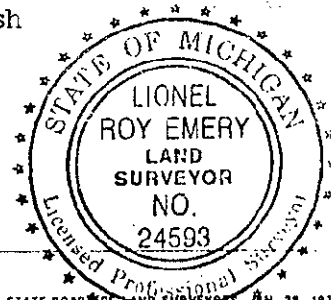

COPY

